

**CODED**

Rankin  
N 18  
7-67

MISSISSIPPI  
BOARD OF WATER COMMISSIONERS  
416 North State Street  
Jackson, Mississippi 39201

WATER WELL DRILLERS LOG

7-14  
date well completed

1967 Forest Drilling  
firm name

Rankin  
county well located

LANDOWNER: Billy Howell

Rt 2

Pelahatchie Miss  
(mailing address)

WELL LOCATION:

sec. 7 T. 5 N. R. 5 E.  
S  
6 mi miles SW of Pelahatchie  
(distance) (direction) (nearest town)

WELL PURPOSE: Home  
(home, irrigation, municipal, industrial)


WELL COMPLETION DATA:

- (1) diameter (inches) 2"
- (2) total depth (feet) 666 ft
- (3) static water level (feet) 188 below top of ground.
- (4) casing Galv. 657  
(material) (depth)
- 2" If telescope see back.  
(size)
- (5) screen 15 ft, 657  
(length) (depth to top)
- 2", Standard steel Johnson  
(size) (material)
- (6) pump 3 HP air, 1000 G.P.H.  
(HP) (yield gpm)
- Elect.  
(type power)
- (7) electric log No  
(yes or no)
- (organization running log)
- (8) how well bottom plugged Backwash  
value

description of formations encountered

	from	to
<u>Red Clay</u>	<u>0</u>	<u>8</u>
<u>Sand</u>		<u>24</u>
<u>Blue Clay</u>	<u>289</u>	<u>380</u>
<u>Shale</u>		<u>380</u>
<u>Hardy Shale</u>		<u>391</u>
<u>Hardy Shell + Clay</u>		<u>411</u>
<u>Shale</u>		<u>473</u>
<u>Shale + Silt Sand</u>		<u>555</u>
<u>Soft Shale</u>		<u>576</u>
<u>Shale + Silt Sand</u>		<u>616</u>
<u>Fine Sand</u>		<u>624</u>
<u>Shale + Silt Sand</u>		<u>636</u>
<u>Fine Sand</u>		<u>650</u>
<u>Shale + Sand</u>		<u>657</u>
<u>Fine - Fine Sand</u>		<u>658</u>
<u>Shale + Silt fine Sand</u>		<u>676</u>
<u>Shale</u>		<u>696</u>


**CODED**

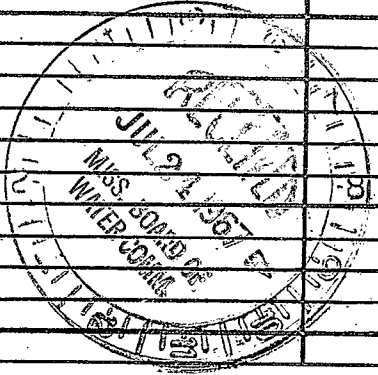

DRILLERS REMARKS:

If well telescopes please sketch and show depths.

GROUND LEVEL

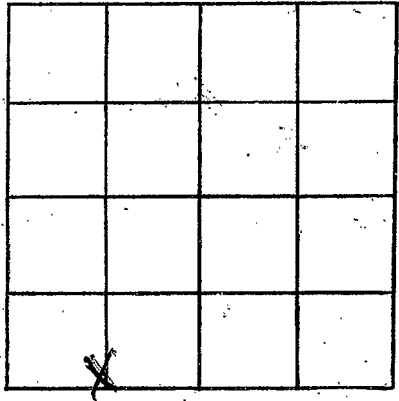

SECTION 7

Please indicate well location X.

ADDITIONAL INFORMATION

If more than one screen, show locations of each on sketch.