

RANKIN MISSISSIPPI BOARD OF WATER COMMISSIONERS

N 19

5-12-66

WATER WELL DRILLERS LOG

CODED

Date: 5/12, 1966, Driller: Just Drilling County Rankin
 (Name)

(1) Owner of Land: <u>H. V. Bones</u> (Name)	Description & Color of Materials Sand, Clay, Red Clay, Shell, etc.	Thick- ness Feet	Depth Feet
<u>At Pelahatchie</u> (Address)	<u>Red Clay</u>		<u>5</u>
(2) Location: <u>1/4</u> , <u>1/4</u> , Sec <u>22</u> T <u>5</u> R <u>5</u> <u>5</u> miles <u>So.</u> of <u>Pelahatchie</u> (distance) (direction) (Nearest Town)	<u>Clay + Sand</u>		<u>12</u>
(3) Topography: _____ (Hilly) (Flat) (Level)	<u>Clay</u>		<u>22</u>
(4) Purpose of Well: <u>Home</u> (Domestic Irrigation Municipal, Industrial, Other)	<u>Clay + 5ths Sand</u>		<u>52</u>
	<u>Blue Clay</u>		<u>112</u>
	<u>Rock</u>		<u>124</u>
	<u>Blue Clay</u>		<u>295</u>
	<u>Shale</u>		<u>340</u>
	<u>Shale + red lime rock</u>		<u>350</u>
	<u>Shale</u>		<u>360</u>
	<u>Shale + lime rock</u>		<u>370</u>
	<u>Shale</u>		<u>400</u>
	<u>Shale</u>		<u>412</u>
	<u>Shaly Shell</u>		<u>422</u>
	<u>Shale</u>		<u>470</u>
	<u>Soft Shale</u>		<u>480</u>
	<u>Soft Shale</u>		<u>500</u>
	<u>Silt</u>		<u>520</u>
	<u>Shale + 5th fine sand</u>		<u>540</u>
	<u>Fine sand</u>		<u>550</u>
	<u>Fine sand</u>		<u>582</u>

Information upon completion of well:

(1) Diameter 2 inches.

(2) Total Depth 582 feet.

(3) Water Level 169 feet below top of ground.

(4) Cased to 567, Size 2"

(5) Screen: Size 2", Length 15ft


(6) Were any formations sealed against pollution?
 _____ yes, no.

If YES depth of formation _____

Why _____

Drillers Remarks: _____

CODED

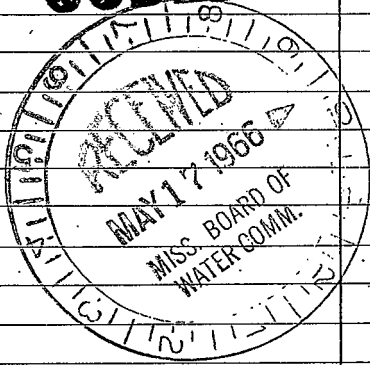

(Use Back Side)

Well No.

