

~~K115~~ N20
5-25-62

WATER WELL DRILLERS LOG

CODED

Date: May 25 1962, Driller: W. G. Butler County Smith
(Name)

(1) Owner of Land: Ned White
(Name)
Pelahatchie, Miss. Rt 2
(Address)
3455
311 T5NR55
(2) Location: 1/4, 1/4, Sec. 311 T5NR55
_____ miles _____ of _____
(distance), (direction) (Nearest Town)
(3) Topography: ✓
(Hilly) (Flat) (Level)
(4) Purpose of Well: Domestic
(Domestic Irrigation, Municipal, Industrial, Other)

Description & Color of Materials Sand, Clay, Red Clay, Shell, etc.	Thick- ness Feet	Depth Feet
Clay	1	10
Chalk + Bonnite	10	18
Rock	18	20
Chalk + Rock	20	25
Rock shell, sand	25	30
sand	30	37
Chalk	37	45
Sand + Chalk	45	52
Sand + Shale	50	60
Chalk	60	90
Licknite + fine sand	90	110
Fine sand	110	127
Chalk	127	130
"	130	140
sand	140	155
Chalk	155	170
Fine sand	170	190
Fine sand + Chalk	190	200


Information upon completion of well:

(1) Diameter 2 inches.
(2) Total Depth 200 feet.
(3) Water Level _____ feet below top of ground.
(4) Cased to 126, Size 5"
(5) Screen: Size 2", Length 10'
(6) Were any formations sealed against pollution?
_____ yes, _____ no.

If YES depth of formation _____
Why _____

Drillers Remarks: _____

CODED

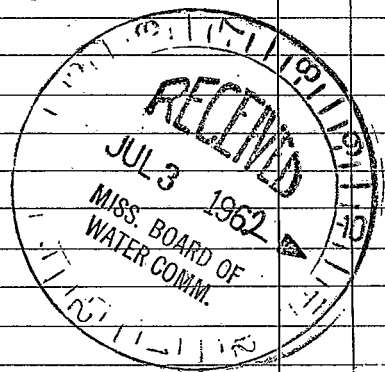

(Use Back Side)

Well No.

1000

1000