

RANKIN MISSISSIPPI BOARD OF WATER COMMISSIONERS

~~37~~ N 21

1-10-63

WATER WELL DRILLERS LOG

CODED

Date: 1-10, 1963, Drillers: Forest Dillingers County: Rankin
(Name)

(1) Owner of Land: Jack Williams
(Name)
Relatchie, Miss
(Address)

(2) Location: 1/4, 1/4, Sec. 4 T5 R5
4 miles North East of Relatchie
(distance) (direction) (Nearest Town)

(3) Topography: (Hilly) (Flat) (Level)

(4) Purpose of Well: _____
(Domestic Irrigation
Municipal, Industrial, Other)

Description & Color of Materials Sand, Clay, Red Clay, Shell, etc.	Thick- ness Feet	Depth Feet
<u>Brown Clay</u>	<u>0</u>	<u>27</u>
<u>fine stone</u>		<u>30</u>
<u>Blue Clay</u>		<u>312</u>
<u>Shaly</u>		<u>385</u>
<u>Silt Sand</u>		<u>395</u>
<u>Shaly</u>		<u>468</u>
<u>Shaly + fine sand</u>		<u>478</u>
<u>Shaly</u>		<u>488</u>
<u>fine sand + shaly</u>		<u>508</u>
<u>fine sand</u>		<u>566</u>

Information upon completion of well:

(1) Diameter 2 inches.

(2) Total Depth 566 feet.

(3) Water Level 160 feet below top of ground.

(4) Cased to 551, Size 2"

(5) Screen: Size 2", Length 15 ft


(6) Were any formations sealed against pollution?
_____ yes, X no.

If YES depth of formation _____

Why _____

Drillers Remarks: _____

CODED

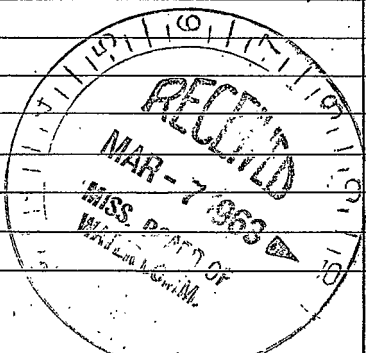

(Use Back Side)

Well No.

1870

1871

1872

1873

1874