

RANKIN
~~ST. N~~ WATER WELL DRILLERS LOG

10-4-62

Date: 10/4, 1962, Driller: Forest Oly...

(Name)

CODED

Rankin
 Smith

- (1) Owner of Land: E. L. Wilkinson
 (Name)
Pellehatchie, Miss.
 (Address)
- (2) Location: 34 T. 5 R. 5
9 miles South, of Pellehatchie
 (distance) (direction) (Nearest Town)
- (3) Topography: X
 (Hilly) (Flat) (Level)
- (4) Purpose of Well: Children's Home
 (Domestic Irrigation, Municipal, Industrial, Other)

Description & Color of Materials Sand, Clay, Red Clay, Shell, etc.	Thick- ness Feet	Depth Feet
Red Clay		16
Red Sand		24
Clay		32
Clay & Shls. Mudy Sand		47
Clay		77
Clay & Mdy Sand		98
Rock		102
Clay & mdy sand		112
Clay		130
fine sand		142
Clay & Shls fine sand		146
Clay		202
Shale		212
Shale & Rock		222
Shale		448
Shale & Shls Rock		512
mdy sand & shale		524
Shale		564
Shale & Shls fine sand		588
Fine sand & Shls Clay		618
Fine sand		628
Fine sand & Shls		638
Fine clay		666


Information upon completion of well:

- (1) Diameter 2" inches.
- (2) Total Depth 666 feet.
- (3) Water Level 188 feet below top of ground.
- (4) Cased to 651, Size 2"
- (5) Screen: Size 2", Length 15ft.
- (6) Were any formations sealed against pollution?
 _____ yes, X no.

If YES depth of formation _____

Why _____

Drillers Remarks: _____

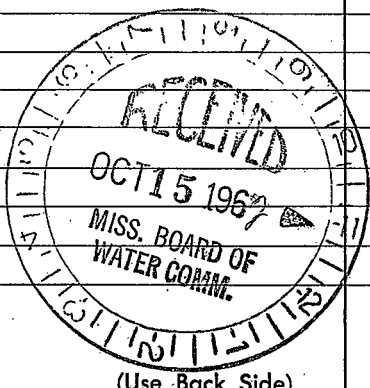

(Use Back Side)

Well No.

100

100

100

100