

N

N 23  
3-26-63

WATER WELL DRILLERS LOG

**CODED** Rankin  
County, Scott  
Name Gen.

Date: 2/26, 1963, Driller: Joseph Williams

(1) Owner of Land: W. E. Hopson  
(Name)  
Delehatie, Miss  
(Address)  
Et 2

(2) Location: 1/4, 1/4, Sec 35 T5 R5  
8 miles South of Delehatie  
(distance) (direction) (Nearest Town)

(3) Topography: \_\_\_\_\_  
(Hilly) (Flat) (Level)

(4) Purpose of Well: Chicken House  
(Domestic Irrigation  
Municipal, Industrial, Other)

Description & Color of Materials Sand, Clay, Red Clay, Shell, etc.	Thick- ness Feet	Depth Feet
Red Clay + Sand	0	11
Blue Clay		22
Clay + mby sand		57
Clay		82
Clay + mby sand		102
Clay		112
Clay + slths fine sand		132
Clay		202
Shale + slths lime rock		217
Shale		430
Shale + slths rock		440
Shale		500
Shale + slths lime rock		570
Shale		586
Shale + slths fine sand		596
Shale + mby sand		646
Shale + mby sand		722
Shale + slths sand		732
fine sand		742
Shale		802

Information upon completion of well:

(1) Diameter 2" inches.

(2) Total Depth 740 feet.


(3) Water Level 209 feet below top of ground.

(4) Cased to 725, Size 2"

(5) Screen: Size 2", Length 15ft.

(6) Were any formations sealed against pollution?  
1 yes, X no.

**CODED**

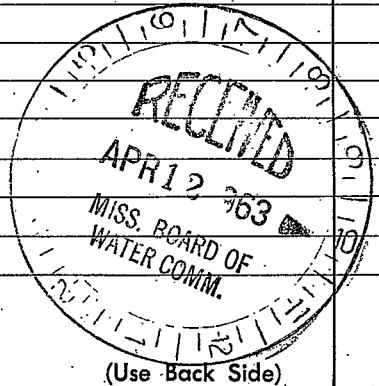

(Use Back Side)

Well No.

