

CODED
CODED

Rankin
N 28
11-10-69

MISSISSIPPI
BOARD OF WATER COMMISSIONERS
416 North State Street
Jackson, Mississippi 39201

WATER WELL DRILLERS LOG

11/10 1969 Forest Drilling Rankin
date well completed firm name county well located

LANDOWNER: Stuckey's
Pecan Lodge
Box 368, Palahatchie Miss.
(mailing address)

description of formations encountered	from	to
yellow clay	0	30
blue clay	30	62
blue shale	62	102
blue clay	102	412
shale + silt + silt	412	422
fine sand + silt shale	422	480
fine sand	480	492
silt shale + sand	492	502
shale	502	512
fine sand	512	560
shale	560	563

WELL LOCATION:
sec. 5 T. 5 N. R. 5 E.
1 miles south of Palahatchie
(distance) (direction) (nearest town)

WELL PURPOSE: industrial
(home, irrigation, municipal, industrial)

- WELL COMPLETION DATA:
- (1) diameter (inches) 4" x 2 1/2"
 - (2) total depth (feet) 561'
 - (3) static water level (feet) 120' below above top of ground.
 - * (4) casing Steel, 541'
(material) (depth)
4" x 2 1/2" If telescope see back.
(size)
 - (5) screen 20', 541'
(length) (depth to top)
3", Stainless Steel
(size) (material)
 - (6) pump 3-1/2 hp 25
(HP) (yield gpm)
Geist
(type power)
 - (7) electric log no
(yes or no)

(organization running log)


(8) how well bottom plugged 2" Backwash
Value

* DRILLERS REMARKS: 296'-4"
Steel Casing
245'-2 1/2" Steel
Casing

- JAN 9 1970
MISS. BD. OF
WATER COMM.

If well telescopes please sketch and show depths.

GROUND LEVEL

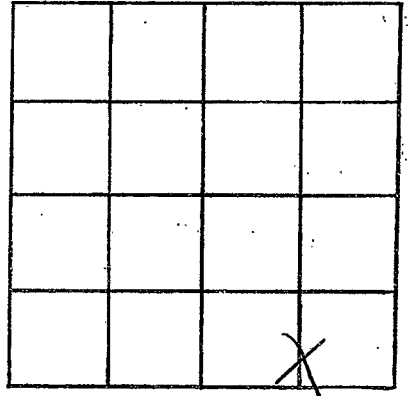

SECTION 5

Please indicate well location X.

ADDITIONAL INFORMATION

If more than one screen,
show locations of each on sketch.