

**RANKIN**  
**N 29**  
**1-27-71**

MISSISSIPPI  
 BOARD OF WATER COMMISSIONERS  
 416 North State Street  
 Jackson, Mississippi 39201

on Hill side  
 elev. 2

**250 topo**  
**CODED**

**WATER WELL DRILLERS LOG**

1-27 1971 Forest Drilling Rankin  
 date well completed firm name county well located

LANDOWNER: **STUCKEY**  
 Standard Oil Service Sta  
 Pelahatchie, Miss  
 (mailing address)

WELL LOCATION: **NE 1/4, SE 1/4**  
 sec. 5 T. 5 N R. 5 E  
 1 miles S of Pelahatchie  
 (distance) (direction) (nearest town)

WELL PURPOSE: **Industrial**  
 (home, irrigation, municipal, industrial)

WELL COMPLETION DATA:

- (1) diameter (inches) 4 x 2 1/2"
- (2) total depth (feet) 579'
- (3) static water level (feet) 120 below top of ground. 355'-4" above
- (4) casing steel 297'-2 1/2"  
 (material) (depth)
- \_\_\_\_\_ if telescope see back.  
 (size)
- (5) screen 20' 552'  
 (length) (depth to top)  
2" Stainless steel  
 (size) (material)
- (6) pump 5 35  
 (HP) (yield gpm)  
230 V  
 (type power) no
- (7) electric log \_\_\_\_\_  
 (yes or no)  
~~\_\_\_\_\_~~  
 (organization running log)
- (8) how well bottom plugged 2"  
Backwash valve

description of formations encountered	from	to
Brown clay	0	42
Blue clay	42	145
shale	145	286
streaks fine sand, silt. clay	286	327
soft clay	327	384
streaks fine sand, clay	384	450
shale	450	490
fine sand	490	545
soft clay	545	552
med. sand	552	577
shale	577	589

**CODED**


DRILLERS REMARKS:

FEB 1 1971

MISS. BD. OF  
 WATER COMM.

If well telescopes please sketch and show depths.

GROUND LEVEL

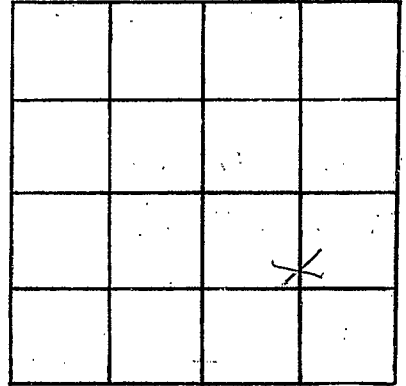

SECTION 5

Please indicate well location X.

ADDITIONAL INFORMATION

If more than one screen,  
show locations of each on sketch.