

MISSISSIPPI BOARD OF WATER COMMISSIONERS

RANKIN
N30
1-8-64

WATER WELL DRILLERS LOG **CODED**

Date: 1/8, 1964, Driller: Just Drilling Service County Rankin
16936 (Name)

(1) Owner of Land: W. D. Rhodes
(Name)
Rt 1 Brandon, Miss.
(Address)
(2) Location: 1/4, 1/4, Sec. 18 T5RS
6 miles SW of De Ridder
(distance) (direction) (Nearest Town)
(3) Topography: ✓
(Hilly) (Flat) (Level)
(4) Purpose of Well: chickens
(Domestic Irrigation
Municipal, Industrial, Other)


Description & Color of Materials Sand, Clay, Red Clay, Shell, etc.	Thick- ness Feet	Depth Feet
Brown clay	0	22
Clay + red sand		42
Blue clay		142
Blue clay + sth lime		152
Blue shale		337
Shale		408
Hard shale		438
Med. Clay + shell		458
Soft shale		480
Shale		530
Shale + sth fine sand		555
Fine sand		569
Shale		575
Shale + sth fine sand		605
Shale		636
Fine sand + sth. shale		646
Shale		671
Yell sand		686
Fine sand		696

Information upon completion of well:

(1) Diameter 2 inches.
(2) Total Depth 687 feet.
(3) Water Level _____ feet below top of ground.
(4) Cased to 672, Size 2"
(5) Screen: Size 2", Length 15 ft.
(6) Were any formations sealed against pollution?
_____ yes, X no.

If YES depth of formation _____
Why _____
Drillers Remarks: _____

CODED

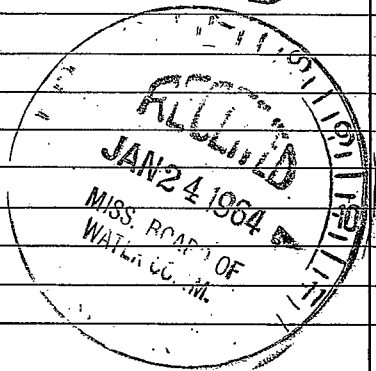

(Use Back Side)

Well No.

