

RANKIN

N31

4-27-62

WATER WELL DRILLERS LOG

FOREST DRILLING SERVICE

CODED

Date: 4/27, 1962, Driller: 231 Highway 35 North County: Forest, MISSISSIPPI

(1) Owner of Land: David F. Lee
 (Name)
Pelahatchie, Miss
 (Address)

(2) Location: 20 55 1/4, 20 55 1/4, Sec. T R
4 miles South of Pelahatchie
 (distance) (direction) (Nearest Town)

(3) Topography: X
 (Hilly) (Flat) (Level)

(4) Purpose of Well: Poultry Farm
 (Domestic Irrigation) (Municipal, Industrial, Other)

Description & Color of Materials Sand, Clay, Red Clay, Shell, etc.	Thick- ness Feet	Depth Feet
Brown Clay	0-26	26
Blue Clay	26-142	142
Shale	142-242	242
Shale + lime rock	242-255	255
Shale	255-302	302
Shale + rock	302-332	332
Mucky sand + clay	332-382	382
Fine sand + stks. clay	382-482	482
Fine sand	482-502	502
Fine sand + clay	502-542	542
Clay + stks. sand	542-552	552
Sh + shale	552-566	566
rock	566-567	567
sand	567-572	572
Fine sand	572-602	602
Fine sand	602-612	612
Hard sand	612-624	624
Sand + clay	624-630	630

Information upon completion of well:

(1) Diameter 2 inches.

(2) Total Depth 624 feet.


(3) Water Level 170 feet below top of ground.

(4) Cased to 609 Size 2"

(5) Screen: Size 2" Length 15'

(6) Were any formations sealed against pollution?
 yes, X no.

CODED

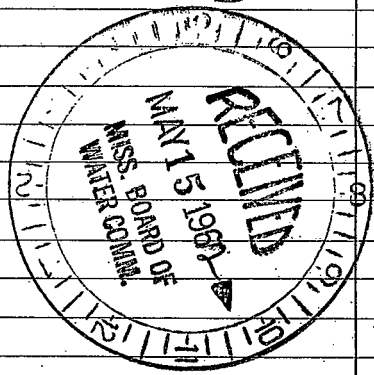

If YES depth of formation _____

Why _____

Drillers Remarks: _____

(Use Back Side)

Well No.

