


N 33

8-16-63

WATER WELL DRILLERS LOG

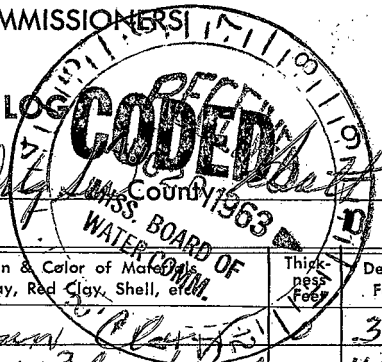

Date: 8-16, 1963, Driller: Frank Dyer, Jr., County: Pearl River, Miss. (Name)

(1) Owner of Land: J.C. Baines (Name)  
Delhatchie, Miss. (Address)  
 (2) Location: 29 55  $\frac{1}{4}$ ,  $\frac{1}{4}$ , Sec. T R  
6 miles South of Delhatchie (distance) (direction) (Nearest Town)  
 (3) Topography: X (Hilly)    (Flat)    (Level)  
 (4) Purpose of Well: Home (Domestic Irrigation, Municipal, Industrial, Other)

Information upon completion of well:

(1) Diameter 2" inches.  
 (2) Total Depth 750 feet.  
 (3) Water Level 200 feet below top of ground.  
 (4) Cased to 735, Size 2"  
 (5) Screen: Size 2", Length 15 ft.  
 (6) Were any formations sealed against pollution?  
   yes, X no.

Description & Color of Material Sand, Clay, Red Clay, Shell, etc.	Thickness Feet	Depth Feet
Brown Clay		32
Clay & Mgy sand		42
Clay		112
Clay & Shs sand		132
Clay		152
Clay & Shs Mgy sand		162
Clay		200
Rock		212
Clay Shell		501
Shell & Shs Rock		571
Sandy Shell		531
Fine sand & Shs clay		551
Shell		605
Shell & Shs fine sand		675
Fine sand		675
Shale		691
Shell & Shs sand		711
Fine sand		721
Fine sand & Shs clay		731
Fine sand		750

CODED

If YES depth of formation \_\_\_\_\_  
 Why \_\_\_\_\_  
 Drillers Remarks: \_\_\_\_\_

(Use Back Side)

Well No.

