

MISSISSIPPI DEPARTMENT OF ENVIRONMENTAL QUALITY

Office of Land and Water Resources

P. O. Box 10631
Jackson, MS 39289-0631
WATER WELL DRILLERS LOG

COUNTY WELL LOCATED Kankin	
WELL NUMBER 342188	CODED
N44	
DATE WELL COMPLETED 8-1-04	

PERMIT NUMBER
NAME OF DRILLING FIRM Easley Waterwell

NAME & MAILING ADDRESS OF LANDOWNER Dewayne Davis			
104 Townsend Rd			
Pelahatchie MS 39145			
Latitude: 321321N			
Longitude: 894409W			
WELL LOCATION	SEC	TOWNSHIP	RANGE
	36	5	5
		(N)	(E)
		S	W
DISTANCE	DIRECTION	NEAREST TOWN	
7	S	of Pelahatchie	
OTHER LANDMARK			
WELL PURPOSE: Home, Irrigation, Municipal, Industrial, Fish Pond, etc. chicken House			

PUMP DATA			
PUMP TYPE (Circle One): <input checked="" type="checkbox"/> Submersible, Turbine, Jet, Flowing Well, Other (Describe) _____			
POWER TYPE (Circle One): <input checked="" type="checkbox"/> Electric, Tractor, Diesel, Gasoline, Butane, Other (Describe) _____ H/P 15			

DESCRIPTION OF FORMATIONS ENCOUNTERED	FROM	TO
Clay	0	425
Sand	425	445
Clay	445	475
Sand	475	490
Clay	490	905
Sand	905	950
Clay	950	1008
Sand	1008	1125
Clay	1125	1220

WELL DATA		
Well Depth 1073'	Casing Diameter (In.) 6"x4"	Casing Length (Ft.) 1052'
Type of Casing Galv.	Hole Depth 1220	Depth to Static Water Level 253'
TYPE OF COMPLETION: (Circle One or More): <input checked="" type="checkbox"/> Gravel Packed, <input type="checkbox"/> Underreamed, <input type="checkbox"/> Telescoped, <input checked="" type="checkbox"/> Natural Development, <input type="checkbox"/> Open Hole, <input type="checkbox"/> Other (Describe) _____		
WELL GROUTED TO A DEPTH OF 100 FEET Type Grout (circle one): <input checked="" type="checkbox"/> Cement, <input type="checkbox"/> Bentonite, or Mix		

SCREEN DATA		
Diameter - Inches 4"	Length - Feet 21"	Slot Size - Inches 008
Screen Type Stainless Steel	Depth to Bottom - Feet 1073'	

RECEIVED	
AUG 10 2004	
BY: OLWR	
Top of Lap Pipe or Reduction in Casing	
FEET	IF TELESCOPED OR MORE THAN ONE SCREEN: USE BACK PAGE

I certify that the well was drilled, constructed and completed in accordance with all applicable Requirements of the Mississippi Department of Environmental Quality and/or the Mississippi Department of Health regulations and state laws.

Larry Easley **510**
Signature of Licensed Driller and License No.

8-1-04
Date

Additional Information Required On Back

8/11/04

If well telescopes please sketch and show depths.

Gave copy to Zico
to Permit -


Gave GS copy -

32.222492

-89.736069

N44 was 1st attempt
784' deep 6" well -

GROUND LEVEL

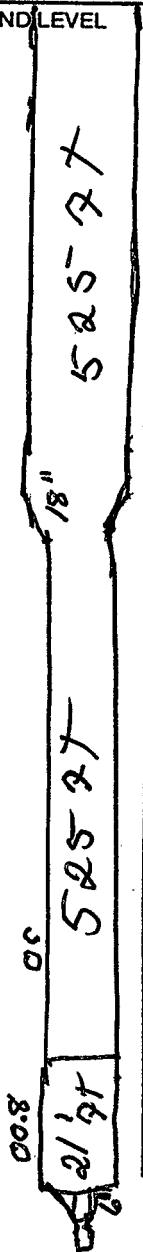

--	--	--	--

SECTION _____

Please indicate well location X.

Pump Capacity (GPM)	No. of Stages	Setting Depth
80'	12	357 FT.

PUMP TEST

Well yielded 150 GPM with
a drawdown of 20 ft.
after 8 hours of pumping

LOG DATA

TYPE OF LOG RUN (Circle One): No Log Run, Electric, Gamma Ray, Density, Sonic, Neutron, Other (Describe) _____

Name of Organization Running Log

DEQ

GEOLOGIC DATA (Office Use Only)

Surface Elev.	Geologic Unit	Unit Thickness	Depth to Top
Subs. SWL	Date	Analysis	Aquifer Test

Driller's Remarks

If more than one screen, show location of each on sketch.