

ELDG # 167

Rankin
030
6-67
Elcc Log
6-6-67
date well completed

MISSISSIPPI
BOARD OF WATER COMMISSIONERS
416 North State Street
Jackson, Mississippi 39201

CODED
MGS
01


WATER WELL DRILLERS LOG

19 James D MRS NEES Rankin
firm name county well located

LANDOWNER: Southern Acres
Dewey Camp
Florence Miss
(mailing address)
WELL LOCATION:
sec. 26 T 4 N R 1 E
2 miles South of Florence
(distance) (direction) (nearest town)
WELL PURPOSE: SUBDIVISION
(home, irrigation, municipal, industrial)

description of formations encountered	from	to
Surface soil	0	10
Clay	10	23
Blue shale	20	43
Blue sh sd strk	43	175
lime sh strk	175	225
Grey sdy sh	225	326
Grey sh	326	751
Grey Green sdy sh	751	811
Grey sdy sh	811	832
Sand	832	852
Sand sh strk	852	938
Sand	938	956
Grey sdy sh	956	974
Sand	974	978
Grey sdy sh	978	1039
39 JTS 2 1/2	804	
40' 2 1/2 stainless steel screen	40	
2 1/2" Pipe	844	
	16	
	850	

WELL COMPLETION DATA:
(1) diameter (inches) 2 1/2
(2) total depth (feet) 1039
(3) static water level (feet) 225 below top of ground.
(4) casing steel, 804 (material) (depth)
2 1/2 (size) if telescope see back.
(5) screen 40' 804 (length) (depth to top)
2 1/2 stainless steel (size) (material)
(6) pump Air Compressor 35 (HP) (yield gpm)
10 HP (type power)
(7) electric log Yes (yes or no)
M.G.S. (organization running log)
(8) how well bottom plugged Mvd

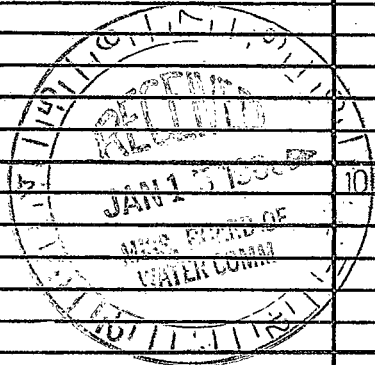

DRILLERS REMARKS:
Water has a little color

If well telescopes please sketch and show depths.

GROUND LEVEL

			X

SECTION 26

Please indicate well location X.

ADDITIONAL INFORMATION

If more than one screen,
show locations of each on sketch.