

MISSISSIPPI BOARD OF WATER COMMISSIONERS

RANKIN
032
7-12-61

WATER WELL DRILLERS LOG

CODED

301
Rankin

Date: July 12, 1961, Driller: W. G. Butler County Smith
(Name)

(1) Owner of Land:	Description & Color of Materials Sand, Clay, Red Clay, Shell, etc.	Thick- ness Feet	Depth Feet
Clyde Long (Name)	Clay	1-	10
Florence Miss (Address)	Chalk	10-	30
SE 1/4, SE 1/4, Sec. 12 T4R1E	Red Chalk	30-	48
1 miles South of Plain (distance) (direction) (Nearest Town)	Blue Gumbo Rock	40- 66-	66 70
Topography: <input checked="" type="checkbox"/> (Hilly) <input type="checkbox"/> (Flat) <input type="checkbox"/> (Level)	Gumbo + shell	70-	100
Purpose of Well: Domestic (Domestic Irrigation Municipal, Industrial, Other)	sand + shell	100-	110
	Gumbo	110-	120
	Gumbo - lignite	120-	130
	Gumbo	130-	135
	sand	135-	140
	Gray chalk + lignite	140-	156
	Fine sand	150-	170
	Gumbo	170-	208

Information upon completion of well:


- (1) Diameter 2 inches.
- (2) Total Depth 200 feet.
- (3) Water Level 70 feet below top of ground.
- (4) Cased to 80', Size 3"
160'
- (5) Screen: Size NO N, Length _____
- (6) Were any formations sealed against pollution?
_____ yes, _____ no.

If YES depth of formation _____

Why _____

Drillers Remarks: _____

CODED

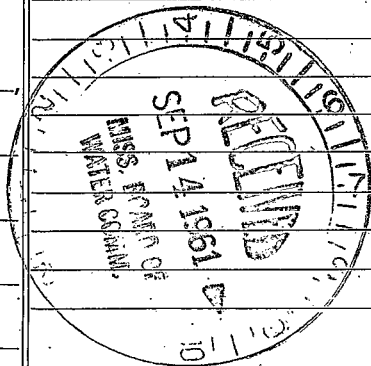

(Use Back Side)

Well No.

[The page contains extremely faint and illegible text, likely bleed-through from the reverse side of the paper. The text is scattered across the page and cannot be transcribed accurately.]