

O35  
5-10-64

WATER WELL DRILLERS LOG

**CODED**  
*Raph*

Date: 5-10-, 1964, Driller: James McNeess County: Hinds  
(Name)

(1) Owner of Land: Willie Dear  
(Name)  
Florence Miss  
(Address)

(2) Location: 1/4, 1/4, Sec. 23 T4R1,  
2 miles SW of Florence,  
(distance) (direction) (Nearest Town)

(3) Topography:  (Hilly)  (Flat)  (Level)

(4) Purpose of Well: Domestic  
(Domestic Irrigation  
Municipal, Industrial, Other)

Description & Color of Materials Sand, Clay, Red Clay, Shell, etc.	Thick- ness Feet	Depth Feet
<u>SURFACE SOIL</u>	<u>15</u>	<u>15</u>
<u>SEND</u>	<u>20</u>	<u>35</u>
<u>CLAY</u>	<u>5</u>	<u>40</u>
<u>BLUE SHALE</u>	<u>24</u>	<u>64</u>
<u>SAND ROCK</u>	<u>5</u>	<u>69</u>
<u>BLUESHALE</u>	<u>115</u>	<u>184</u>
<u>ROCK SH STKS</u>	<u>9</u>	<u>193</u>
<u>ROCK SD STKS</u>	<u>11</u>	<u>204</u>
<u>ROCK</u>	<u>3</u>	<u>207</u>
<u>SEND-SH STKS</u>	<u>8</u>	<u>215</u>
<u>GREY SHALE</u>	<u>21</u>	<u>236</u>

Information upon completion of well:

(1) Diameter 2 inches.

(2) Total Depth 236 feet.


(3) Water Level 86 feet below top of ground.

(4) Cased to 190' 6", Size 2

(5) Screen: Size NONE, Length \_\_\_\_\_

(6) Were any formations sealed against pollution?  
\_\_\_\_\_ yes,  no.

**CODED**

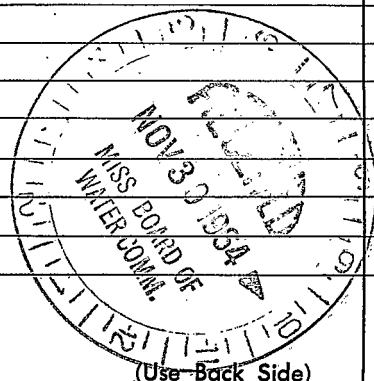

(Use Back Side)

Well No.

100

100

100