

RANKIN

MISSISSIPPI BOARD OF WATER COMMISSIONERS

~~K-107~~ 037

3-14-61

WATER WELL DRILLERS LOG

2

CODED

Date: MAR. 14 19 61, Driller: W. G. Butler County Rankin

(Name)

Rankin

(1) Owner of Land: R. O. Burns
(Name)
Florence, Miss Rt-2
(Address)

(2) Location: N 1/2 SE 1/4, Sec. 12 T5 R1E
East Hwy. 49
4 miles South, of Jackson
(distance) (direction) (Nearest Town)

(3) Topography: (Hilly) (Flat) (Level)

(4) Purpose of Well: Domestic
(Domestic Irrigation
Municipal, Industrial, Other)

Description & Color of Materials Sand, Clay, Red Clay, Shell, etc.	Thick- ness Feet	Depth Feet
Top soil	0-1	
Red clay	1-15	
Chalk + clay	15-30	
Rock Formation	30-60	
Sand + shale	60-70	
Gumbo + lignite	70-75	
Blue Gumbo + lignite	75-80	
Sand + shale	80-90	
Blue Gumbo + lignite	90-100	
Shale + sand	100-105	
Blue Gumbo	105-115	
Gumbo	115-120	
sand + shale	120-160	

Information upon completion of well:

(1) Diameter 2 inches.

(2) Total Depth 160 feet.

(3) Water Level 105 feet below top of ground.

(4) Cased to 130', Size 2"

(5) Screen: Size 2", Length 10'


(6) Were any formations sealed against pollution?
 yes, no.

If YES depth of formation 63' 3" pipe

Why Seal off seep water

Drillers Remarks:

CODED

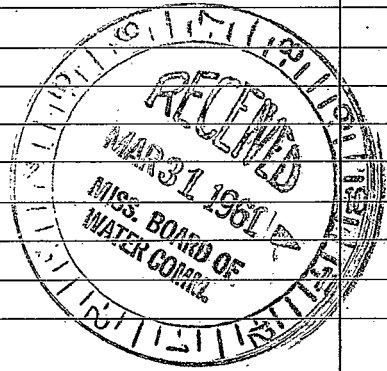

(Use Back Side)

Well No.

11/10/20

Dear Sir,
I am writing to you regarding the matter of the...

I have been informed that you are interested in...

The details of the project are as follows...

I would be pleased to discuss this further...

Yours faithfully,
[Signature]

Enclosed please find the documents mentioned above.