

RANKIN

MISSISSIPPI BOARD OF WATER COMMISSIONERS

038

1-22-64

WATER WELL DRILLERS LOG

CODED

Rankin  
Hinds

Date: 1-22, 1964, Drillers: James M<sup>c</sup>Neels County: Hinds  
(Name)

(1) Owner of Land: Paul Shaws  
(Name)  
Florence Miss  
(Address)

(2) Location: 1/4, 1/4, Sec. 35 T 4R,  
2 miles S.W., of Florence  
(distance) (direction) (Nearest Town)

(3) Topography:  (Hilly)  (Flat)  (Level)

(4) Purpose of Well: Domestic  
(Domestic Irrigation  
Municipal, Industrial, Other)

Description & Color of Materials Sand, Clay, Red Clay, Shell, etc.	Thick- ness Feet	Depth Feet
Surface soil	10	10
Sand	40	50
Blue shale	35	85
Grey sh. strk lignite	41	126
Grey shale	64	190
Rock. shale strk	26	216
Grey sdv sh	40	256
10 strk - 2"	209	
1-3"x2" swedge		8"
1 3" Coupling		4"
1-3"x2" swedge		8"
1-2" collar nipple		8"
		28
		24
		4

Information upon completion of well:

(1) Diameter: 2 inches.

(2) Total Depth: 256 feet.


(3) Water Level: 96 feet below top of ground.

(4) Cased to 211, Size 8"

(5) Screen: Size None, Length \_\_\_\_\_

(6) Were any formations sealed against pollution?  
\_\_\_\_\_ yes,  no.

CODED

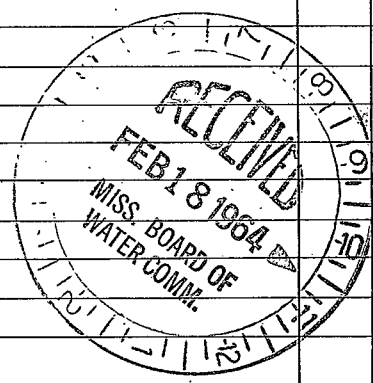

If YES depth of formation \_\_\_\_\_

Why \_\_\_\_\_

Drillers Remarks: \_\_\_\_\_

Well No.

(Use Back Side)

1948