

RANKIN MISSISSIPPI BOARD OF WATER COMMISSIONERS

WATER WELL DRILLERS LOG

**CODED**

Date: MARCH 14 1961, Driller: W. G. Butler County Rankin

(1) Owner of Land: SS. Terry  
(Name)

Florence Miss. Rt - 2  
(Address)

(2) Location: N 1/4 SE 1/4, Sec. 12, T5 R1E  
East of Hwy 49 - Miss  
1/4 miles South of Jackson  
(distance) (direction) (Nearest Town)

(3) Topography:  (Hilly)  (Flat)  (Level)

(4) Purpose of Well: Domestic  
(Domestic Irrigation, Municipal, Industrial, Other)

Information upon completion of well:

(1) Diameter 2" inches.

(2) Total Depth 155 feet.

(3) Water Level 100 feet below top of ground.

(4) Cased to 126', Size 2"

(5) Screen: Size 2", Length 10'

(6) Were any formations sealed against pollution?  
\_\_\_\_\_ yes, \_\_\_\_\_ no.


If YES depth of formation \_\_\_\_\_

Why \_\_\_\_\_

Drillers Remarks: \_\_\_\_\_

Description & Color of Materials Sand, Clay, Red Clay, Shell, etc.	Thick- ness Feet	Depth Feet
TOP Soil	0 - 1	
Red Clay	1 - 10	
Chalk + Clay	10 - 25	
Rock Formation	25 - 55	
Lignite	55 - 60	
Shale + Sand	60 - 65	
Blue Gumbo	65 - 70	
Shale + sand	70 - 75	
Blue Gumbo + Lignite	75 - 80	
Sandy shale	80 - 85	
Blue Gumbo	85 - 90	
Blue Gumbo	90 - 95	
Shale + Sand	95 - 100	
Gumbo	100 - 105	
Gumbo	105 - 110	
Gumbo + sand	110 - 115	
" "	115 - 120	
Sand + shale	120 - 130	
" "	130 - 140	
" "	140 - 150	
Gumbo	150 - 155	

**CODED**

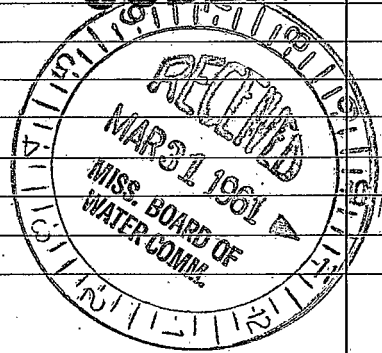

(Use Back Side)

Well No.

1931

1. The first part of the report deals with the general situation of the country and the progress of the work during the year.

2. The second part deals with the results of the work done during the year.

3. The third part deals with the conclusions drawn from the work done during the year.

4. The fourth part deals with the suggestions for the future work.

5. The fifth part deals with the summary of the work done during the year.

1931