

RANKIN MISSISSIPPI BOARD OF WATER COMMISSIONERS

U.S. Geological Survey 09

5-3-65
042

WATER WELL DRILLERS LOG

CODED Rankin
Miss

Date: 5-3-65, 19___, Drillers: James McNew, County: Rankin

(Name)

4

(1) Owner of Land: W.C. Hempill
(Name)
Florence Miss
(Address)
204-1
(2) Location: NE 1/4, SW 1/4, Sec. 20, T. 1 N, R. 1 E
1/2 mile south of Florence
(distance) (direction) (Nearest Town)
(3) Topography: (Hilly) (Flat) (Level)
(4) Purpose of Well: DOMESTIC
(Domestic Irrigation, Municipal, Industrial, Other)

Description & Color of Materials Sand, Clay, Red Clay, Shell, etc.	Thick- ness Feet	Depth Feet
SURFACE soil	10	10
ROCK-shale streaks	30	40
SAND-shale shale	20	60
Gray shale	80	140
SAND-sh. STKS	40	180
SAND	86	266
Gray shale	97	313
ROCK	2	315
Gray shale	330	645
Gray sdy sh	55	700
SAND	6	706
SAND-sh STKS	60	766
Gray shale	56	822
Gray sdy sh	35	857
SAND	95	952
shale	23	975
Gray sdy sh	20	995
16 Joints 4"	339	
1-4" x 2" swedge	1	
26 Joints 2"	542	
30' 2" .008 sds	30	
1-2" Tail Pipe	912	
4 B.P.V.	5	
	917	


Information upon completion of well:

(1) Diameter: 4" x 2" inches.
(2) Total Depth: 995 feet.
(3) Water Level: 145 feet below top of ground.
(4) Cased to: 882, Size: 4" x 2"
(5) Screen: Size: 2.008, Length: 30
(6) Were any formations sealed against pollution?
_____ yes, no.

If YES depth of formation _____
Why _____

Drillers Remarks: _____

CODED

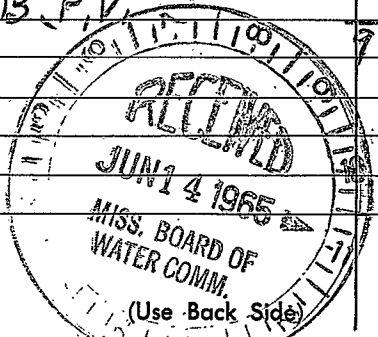

Well No.

