

RANKIN
 046
 7-10-78
 Eln # 454

MISSISSIPPI
 BOARD OF WATER COMMISSIONERS CODED
 416 North State Street
 Jackson, Mississippi 39201

WATER WELL DRILLERS LOG

7/10/78 19 Sumner water well Rankin
 date well completed firm name county well located

LANDOWNER: James N. Lang
 (mailing address)

description of formations encountered	from	to
clay	0	60
rock	60	80
S.A. rock	80	100

WELL LOCATION:
 sec. 13 T 4 N R 1 E
 S W
 miles of
 (distance) (direction) (nearest town)

yr. clay	100	250 230
----------	-----	-----------------------

WELL PURPOSE:
 (home, irrigation, municipal, industrial)

WELL COMPLETION DATA:
 (1) diameter (inches) 4
 (2) total depth (feet) 100
 (3) static water level (feet) 30 below above top of ground.
 (4) casing PVC 80
 (material) (depth)
4 If telescope see back.
 (size)
 (5) screen 20 80
 (length) (depth to top)
4 PVC
 (size) (material)
 (6) pump 1/2 10
 (HP) (yield gpm)
 (type power)
 (7) electric log (yes or no)
MGS
 (organization running log)
 (8) how well bottom plugged BWV

CODED		
-------	--	--


DRILLERS REMARKS:

RECEIVED
 JUL 31 1978

MISS. DEP. OF WATER CONTROL

If well telescopes please sketch and show depths.

GROUND LEVEL

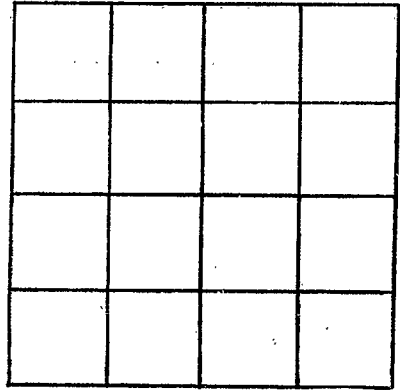

SECTION _____

Please indicate well location X.

ADDITIONAL INFORMATION

A series of horizontal lines for recording additional information.

If more than one screen, show locations of each on sketch.