

RANKIN
 041
 9-25-78
 Elog #470

MISSISSIPPI
 BOARD OF WATER COMMISSIONERS
 416 North State Street
 Jackson, Mississippi 39201

CODED

WATER WELL DRILLERS LOG

9/25/78 date well completed 1978 Jack Guinn Water Well Co. Rankin firm name county well located

LANDOWNER: P.C. Rogers
 Florence

(mailing address)

WELL LOCATION:
 sec. 26 (T) 4 (N) (R) 1 (E)
 S W
 5 mi. miles S.W. of Florence
 (distance) (direction) (nearest town)

WELL PURPOSE:
 (home) Irrigation, municipal, industrial

WELL COMPLETION DATA:

- (1) diameter (inches) 6 in
- (2) total depth (feet) 326
- (3) static water level (feet) 135 ft below top of ground.
- (4) casing P.V.C. 40 300 ft.
 (material) (depth)
- (size) If telescope see back.
- (5) screen 20 ft. 280-300
 (length) (depth to top)
- 4 in. P.V.C. 40
 (size) (material)
- (6) pump 1 1/2 30 gpm
 (HP) (yield gpm)
- Electric
 (type power)
- (7) electric log yes
 (yes or no)
- M.D.S.
 (organization running log)
- (8) how well bottom plugged back
 wash valve

DRILLERS REMARKS:

description of formations encountered	from	to
Red sand	0	28
yellow clay	28	180
sandy shell	180	280
water sand	280	300


CODED

RECEIVED
 SEP 27 1978

MISSISSIPPI BOARD OF WATER COMMISSIONERS

If well telescopes please sketch and show depths.

GROUND LEVEL

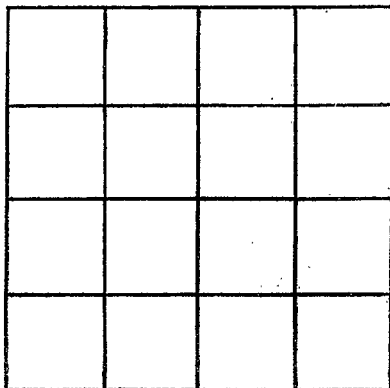

SECTION _____

Please indicate well location X.

ADDITIONAL INFORMATION

If more than one screen, show locations of each on sketch.