

MISSISSIPPI DEPARTMENT OF NATURAL RESOURCES

Bureau of Land and Water Resources

Southport Mall

P.O. Box 10631

CODED

Jackson, Mississippi 39209

WATER WELL DRILLERS LOG

RANKIN
 #48
 12-17-78
 Elog #482

1978 Jack D. Dunn

Rankin

date well completed

firm name

county well located

LANDOWNER:

Ernest Rogers

(mailing address)

WELL LOCATION:

sec 26 T 4 N R 1 E S W

(distance) miles (direction) of (nearest town)

WELL PURPOSE: home
 (home, irrigation, municipal, industrial)

CODED

WELL COMPLETION DATA:

- (1) diameter (inches) 4 1/2
- (2) total depth (feet) 150
- (3) static water level (feet) 100 below above top of ground.

(4) casing pvc 160
 (material) (depth)
4 1/2
 (size) if telescope see back.

(5) screen 30 140
 (length) (depth to top)
4 1/2 pvc
 (size) (material)

(6) pump 1 100
 (HP) (yield gpm)
 (type power)

(7) electric log yes or no
MGS
 (organization running log)

(8) how well bottom plugged 15' c/w

description of formations encountered

from

to

SAND 0 50
 CLAY 50 160
 SAND 160 180

DRILLERS REMARKS:


DEPT. OF NATURAL RESOURCES
 BUREAU OF LAND & WATER RESOURCES

DEC - 9 1980

RECEIVED

If well telescopes please sketch and show depths.

GROUND LEVEL

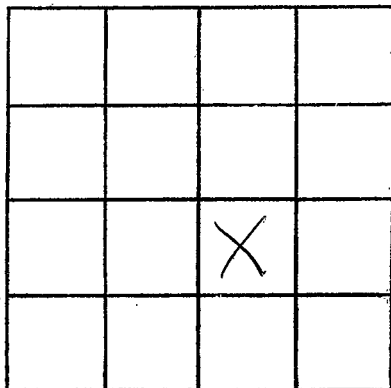

SECTION 26

Please indicate well location X.

ADDITIONAL INFORMATION

If more than one screen, show locations of each on sketch.