

RANKIN

MISSISSIPPI BOARD OF WATER COMMISSIONERS 416 North State Street Jackson, Mississippi 39201

WATER WELL DRILLERS LOG RANKIN

HANDS \$2000 10-16-75

10-14 date well completed 75 W. K. Barnes Water Well Drilling firm name Rankin county well located


LANDOWNER: Gray Gatten Rt. 1 Florence, Miss. (mailing address)

WELL LOCATION: sec. 13 T. 4 N. R. 1 E 3 miles N.W. of Florence (distance) (direction) (nearest town)

WELL PURPOSE: Home use (home, irrigation, municipal, industrial)

WELL COMPLETION DATA: (1) diameter (inches) 2 (2) total depth (feet) 941 (3) static water level (feet) 220 below top of ground. (4) casing Galv. (material) (depth) 2" (size) If telescope see back. (5) screen 20 ft. (length) (depth to top) 06 (size) 5' (material) (6) pump Air Compressor 1.5 (HP) (yield gpm) Elec. (type power) (7) electric log NO (yes or no) (organization running log) (8) how well bottom plugged Wash valve


Table with 3 columns: description of formations encountered, from, to. Rows include Red clay, yellow clay, Blue clay, Rock, Blue clay, Rock, Blue clay, Fine sand, Blue clay, Rock, Blue clay, Fine sand, Pull back set of screens at 741.

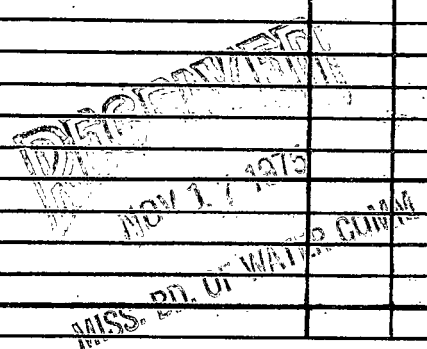

DRILLERS REMARKS:

If well telescopes please sketch and show depths.

GROUND LEVEL

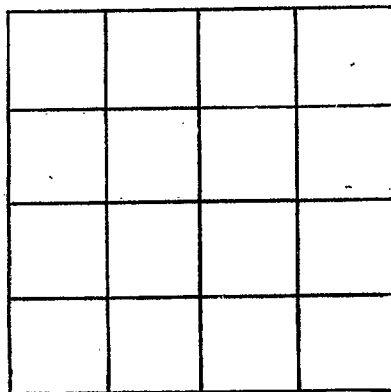

SECTION 23

Please indicate well location X.

ADDITIONAL INFORMATION

If more than one screen,  
show locations of each on sketch.