

**CODED**

P35  
11-10-62

WATER WELL DRILLERS LOG

Date: 11-10, 1962, Driller: James Mc Nees County Hinds

(Name)

(1) Owner of Land: F. B. Pittman  
(Name)  
JACKSON  
(Address)

(2) Location: NW 1/4, SE 1/4, Sec 8 T1 R2E  
4 miles NE of FLORENCE  
(distance) (direction) (Nearest Town)

(3) Topography:  (Hilly)  (Flat)  (Level)

(4) Purpose of Well: Domestic  
(Domestic Irrigation  
Municipal, Industrial, Other)

Description & Color of Materials Sand, Clay, Red Clay, Shell, etc.	Thick- ness Feet	Depth Feet
Surface Soil - Rock	20	20
Blue shale - lignite	20	40
Grey shale	69	109
Rocky sh strcs	29	138
Lime	5	143
Grey shale	8	151
Grey sh sd strcs	13	164
Grey shale	86	250

Information upon completion of well:

(1) Diameter 4-2 inches.

(2) Total Depth 250 feet.

(3) Water Level 67 feet below top of ground.


(4) Cased to 151, Size 4" x 2"

(5) Screen: Size 2" 008, Length 10

(6) Were any formations sealed against pollution?  
 \_\_\_\_\_ yes,  no.

7 fts 4"	146	4"
1 4" x 2" swedac	1	
1.2" Nipple	3	8"
1.2" 008 SS screen	10	
	161	

**CODED**

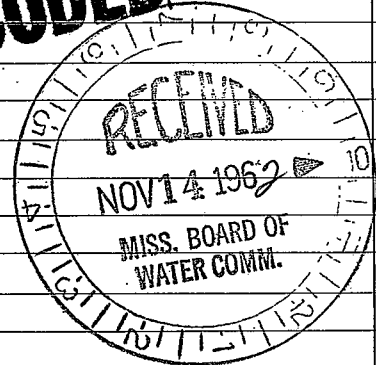

If YES depth of formation \_\_\_\_\_

Why \_\_\_\_\_

Drillers Remarks: \_\_\_\_\_

(Use Back Side)

Well No.

