

RANKIN MISSISSIPPI BOARD OF WATER COMMISSIONERS

P36

11-10-62

WATER WELL DRILLERS LOG

**CODED**

Rankin  
Hinds

Date: 11-10-, 1962, Driller: James McNeese County: Hinds

(Name)


(1) Owner of Land	Description & Color of Materials	Thick-ness Feet	Depth Feet
<u>Florence High School</u> (Name)	<u>Surface Soil</u>	<u>10</u>	<u>10</u>
<u>Florence Miss</u> (Address)	<u>2nd</u>	<u>20</u>	<u>30</u>
(2) Location: <u>NW 1/4, NE 1/4, Sec 29 T 4 N R 2 E</u>	<u>Grey shale</u>	<u>20</u>	<u>100</u>
<u>1</u> miles <u>North</u> of <u>Florence</u> (distance), (direction), (Nearest Town)	<u>3rd</u>	<u>29</u>	<u>129</u>
(3) Topography: <input checked="" type="checkbox"/> (Hilly) <input type="checkbox"/> (Flat) <input type="checkbox"/> (Level)	<u>Grey shale</u>	<u>9</u>	<u>138</u>
(4) Purpose of Well: <u>School</u> (Domestic Irrigation, Municipal, Industrial, Other)	<u>Rock-sh sh stks</u>	<u>36</u>	<u>174</u>
	<u>Grey shale</u>	<u>66</u>	<u>240</u>
	<u>Grey sdy sh</u>	<u>9</u>	<u>249</u>
	<u>Grey shale</u>	<u>60</u>	<u>308</u>

Information upon completion of well:

- (1) Diameter 4" x 2" inches.
- (2) Total Depth 308 feet.
- (3) Water Level 12 feet below top of ground.
- (4) Cased to 106', Size 4"
- (5) Screen: Size 2" 010, Length 10
- (6) Were any formations sealed against pollution?  
 yes,  no.

<u>5 fts 4"</u>	<u>105'</u>
<u>1-4" x 2" swedge</u>	<u>1</u>
<u>1-2" 010 ss screen</u>	<u>106</u>
<u>1-2" Tail pipe</u>	<u>10</u>
<u>1-2" Nip collar</u>	<u>126</u>
<u>2 B P V</u>	<u>4</u>
	<u>130</u>
	<u>131</u>

**CODED**

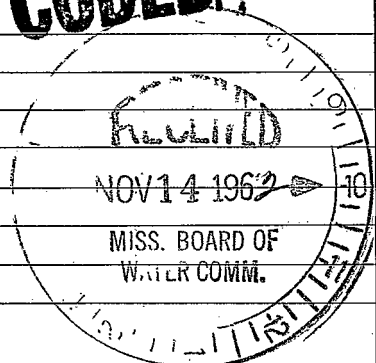

(Use Back Side)

Well No.

