

CODED

MISSISSIPPI
BOARD OF WATER COMMISSIONERS
416 North State Street
Jackson, Mississippi 39201

MGS
P4

WATER WELL DRILLERS LOG

Rankin
P49
8-66
E-109

8-17 1966 date well completed
Hater Hill Sec. Co. firm name
Rankin county well located

LANDOWNER: Sam Billinger
Rt.
Houma, Miss.
(mailing address)

description of formations encountered	from	to
	Clay	0
Sand	170	188
Sand + Rock	188	200
Sand	200	236
Blue clay	236	280

WELL LOCATION: NW, SE, SE
sec. 23 T 4 N R 2 E
S W
4 miles N of Houma
(distance) (direction) (nearest town)

WELL PURPOSE: Home
(home, irrigation, municipal, industrial)

WELL COMPLETION DATA:

- (1) diameter (inches) 2"
- (2) total depth (feet) 280
- (3) static water level (feet) 100 ^{below} _{above} top of ground:
- (4) casing 0
(material) (depth)
(size) If telescope see back.
- (5) screen 15 181
(length) (depth to top)
2" S.S.
(size) (material)
- (6) pump 3/4 8
(HP) (yield gpm)
Elec.
(type power)
- (7) electric log yes
(yes or no)
Miss. S.S.
(organization running log)
- (8) how well bottom plugged _____


CODED

JUL - 8 1968
MISS. BOARD OF
WATER COMMISSIONERS

DRILLERS REMARKS:

If well telescopes please
sketch and show depths.

GROUND LEVEL

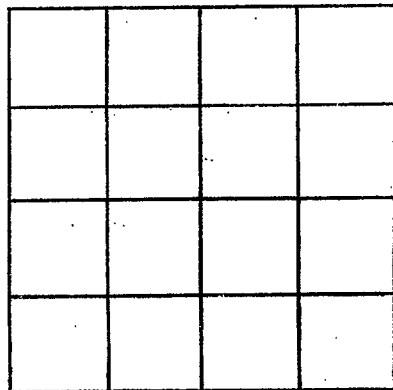

SECTION _____

Please indicate well location X.

ADDITIONAL INFORMATION

If more than one screen,
show locations of each on sketch.