

Rankin
P50
10-66
Elec Log

MISSISSIPPI
BOARD OF WATER COMMISSIONERS
416 North State Street
Jackson, Mississippi 39201

MCS
P15
CODED

WATER WELL DRILLERS LOG


10-10-66 19 Gordon & McNeers Rankin
date well completed firm name county well located
10-10-66

LANDOWNER: R.T. Braddy
FLORENCE MISS
(mailing address)
WELL LOCATION:
sec 35 T 4 N R 2 E
4 miles E of Florence
(distance) (direction) (nearest town)

description of formations encountered	from	to
surface soil	0	5
Rock-sh strks	5	20
sand	20	28
Blue shale	28	114
sand	114	145
Grey sh sd strks	145	165
Grey shale	165	239
Rock. sh strks	239	277
Grey sh sd strks	277	287
Grey sh	287	305
sand	305	307
Grey sdy sh	307	317
Grey sh	317	327
Grey sdy sh	327	348
Grey sh	348	791
Grey-green sdy sh	791	811
Grey sh	811	873
Grey sdy sh	873	958
sand	958	985
Grey sdy sh, sd strks	985	995
sand	995	1018
Grey sh sd strks	1018	1056

WELL PURPOSE:
(home, irrigation, municipal, industrial)

WELL COMPLETION DATA:
(1) diameter (inches) 4" x 2 1/2"
(2) total depth (feet) 1056
(3) static water level (feet) 171 below top of ground.
(4) casing steel 960 (material), (depth)
4" x 2 1/2" (size) if telescope see back,
(5) screen 30' 960 (length), (depth to top)
2 1/2" stainless steel (size) (material)
(6) pump 2 (HP), 20 (yield gpm)
Electric (type power)
(7) electric log yes (yes or no)
Miss. G.S. (organization running log)
(8) how well bottom plugged Back wash valve

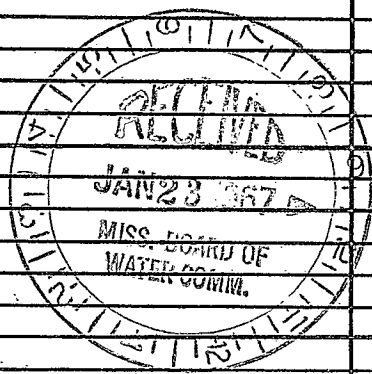

DRILLERS REMARKS:
Water ~~with~~
No color

