

**CODED**

MISSISSIPPI  
BOARD OF WATER COMMISSIONERS  
416 North State Street  
Jackson, Mississippi 39201

MGS  
PT

**WATER WELL DRILLERS LOG**

Rankin  
P51  
6-67  
E-109  
6-6 1967

Water Well Serv. Co. Rankin  
date well completed firm name county well located

LANDOWNER: Jerry Meadows  
Rt. Florence, Miss.

description of formations encountered	from	to
Clay + sand	0	30
Clay	30	160
Rocks + Blue clay	160	180
Sand	180	210
Sand + clay	210	276

(mailing address)  
WELL LOCATION: 3E, SE, SW  
sec. 13 T 4 N R 2 E  
S W

\_\_\_\_\_ miles \_\_\_\_\_ of \_\_\_\_\_  
(distance) (direction) (nearest town)

WELL PURPOSE: Home  
(home, irrigation, municipal, industrial)

**WELL COMPLETION DATA:**

- (1) diameter (inches) 2"
- (2) total depth (feet) 276
- (3) static water level (feet) 60 <sup>below</sup> <sub>above</sub> top of ground.
- (4) casing \_\_\_\_\_ (material) \_\_\_\_\_ (depth) \_\_\_\_\_ (size) if telescope see back.
- (5) screen 10' 200  
(length) (depth to top)  
2" S.S.  
(size) (material)
- (6) pump 3/4 10  
(HP) (yield gpm)  
Elec.  
(type power)
- (7) electric log Yes  
(yes or no)  
Miss. Res. Sur.  
(organization running log)
- (8) how well bottom plugged \_\_\_\_\_


**CODED**

JUL - 8 1968  
MISS. BOARD OF  
WATER COMM.

DRILLERS REMARKS: \_\_\_\_\_

If well telescopes please sketch and show depths.

GROUND LEVEL

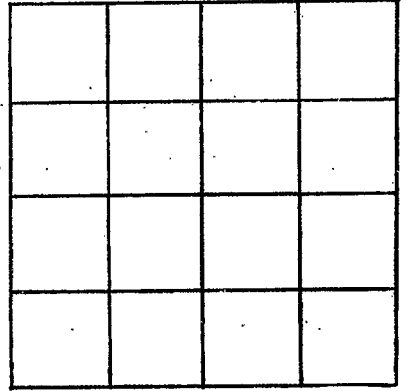

SECTION \_\_\_\_\_

Please indicate well location X.

ADDITIONAL INFORMATION

If more than one screen, show locations of each on sketch.