

CODED

MISSISSIPPI
BOARD OF WATER COMMISSIONERS
416 North State Street
Jackson, Mississippi 39201

WATER WELL DRILLERS LOG

Rankin
P 52
11-67
Elec Log
11-1-67
date well completed

Gordon-McNees firm name
RANKIN county well located

LANDOWNER: F.R. Abernathy
Florence Miss
(mailing address)

description of formations encountered	from	to
<u>Clay</u>	<u>0</u>	<u>23</u>
<u>Grey shale</u>	<u>23</u>	<u>100</u>
<u>ROCK SH STRS</u>	<u>100</u>	<u>134</u>
<u>Grey shale</u>	<u>134</u>	<u>149</u>
<u>Grey sd sh</u>	<u>149</u>	<u>161</u>
<u>SAND</u>	<u>161</u>	<u>162</u>
<u>Grey sd sh</u>	<u>162</u>	<u>174</u>
<u>SAND</u>	<u>174</u>	<u>175</u>
<u>Grey sh sd STRS</u>	<u>175</u>	<u>183</u>
<u>Grey sh</u>	<u>183</u>	<u>203</u>


WELL LOCATION:
sec. 17 T. 4 N. R. 2 E
4 miles NW of Florence
(distance) (direction) (nearest town)

WELL PURPOSE: HOME
(home, irrigation, municipal, industrial)

WELL COMPLETION DATA:

(1) diameter (inches) 4" x 2"
(2) total depth (feet) 203
(3) static water level (feet) 70 below top of ground.
(4) casing steel 127
(material) (depth)
4" x 2 if telescope see back.
(size)
(5) screen 8' 127
(length) (depth to top)
2" plastic
(size) (material)
(6) pump 1/2 9
(HP) (yield gpm)
Elec
(type power)
(7) electric log yes
(yes or no)
M.G.S.
(organization running log)
(8) how well bottom plugged mud

CODED

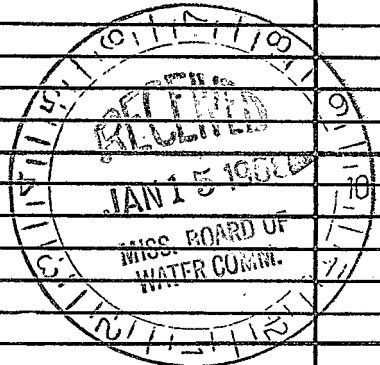

DRILLERS REMARKS:
Water clear

