

RANKIN
 P 53
 1-68

MISSISSIPPI
 BOARD OF WATER COMMISSIONERS
 416 North State Street
 Jackson, Mississippi 39201

CODED 165
 7

MISS. GEO. SURV. 1-27

WATER WELL DRILLERS LOG

1-27 1968 Forest Drilling Serv. Rankin
 date well completed firm name county well located

LANDOWNER: David Hale
 2859 Teresa Drive
 Jackson, Miss
 (mailing address)


description of formations encountered	from	to
Green Clay	0	26
Blue Clay		82
Clay & Shell		96
Clay		102
Clay & Mts Rock		122
Clay		140
Clay & Silt		162
Clay & Silt		204
Blue Clay		245
Shale		514
Hard Shale		555
Shale		697
Soft Shale & Silt		719
Shale & Silt		797
Shale		817
Soft Shale & Silt		877
Soft Shale & Fine Sand		922
Fine Sand & Silt		914
Shale		

WELL LOCATION:
 sec. 17 T 4 N R 21 E
 S W
 (distance) miles (direction) of (nearest town)

WELL PURPOSE: Home
 (home, irrigation, municipal, industrial)

WELL COMPLETION DATA:
 (1) diameter (inches) 2"
 (2) total depth (feet) 958
 (3) static water level (feet) 200 below top of ground.
 (4) casing Galv. 938 (material) (depth)
 2" (size) if telescope see back.
 (5) screen 20ft 938 (length) (depth to top)
 2" (size) Stainless Steel (material)
 (6) pump 5 (HP) 1000 GPM (yield gpm)
 Electric (type power)
 (7) electric log Yes (yes or no)
 Miss. Geog. (organization running log)
 (8) how well bottom plugged backward

CODED

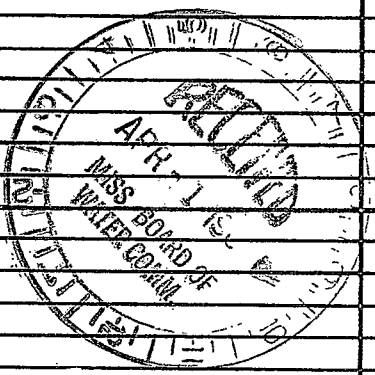


DRILLERS REMARKS:

If well telescopes please sketch and show depths.

GROUND LEVEL

NW 4
NE 4

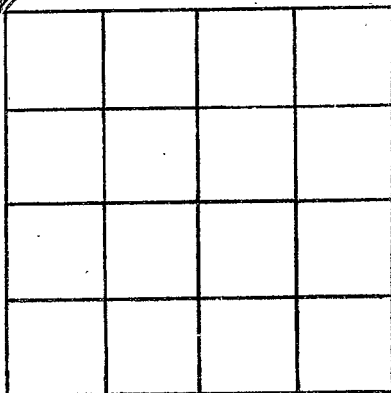

SECTION 17

Please indicate well location X.

ADDITIONAL INFORMATION

If more than one screen, show locations of each on sketch.