

CODED

RANKIN
F58
12-67

MISSISSIPPI
BOARD OF WATER COMMISSIONERS
416 North State Street
Jackson, Mississippi 39201

WATER WELL DRILLERS LOG

Dec-20 1967 W. H. Butler Rankin
date well completed firm name county well located

LANDOWNER: SIMON THAMES

Florence, Miss.

(mailing address)

WELL LOCATION:


sec 32 T 4 N R 2 E
S W
1 miles E of Florence
(distance) (direction) (nearest town)

WELL PURPOSE: Home
(home, irrigation, municipal, industrial)

WELL COMPLETION DATA:

- (1) diameter (inches) 2"
- (2) total depth (feet) 388
- (3) static water level (feet) _____ below above top of ground.
- (4) casing 9241, 368' (material) (depth)
2" if telescope see back. (size)
- (5) screen 10' 368' (length) (depth to top)
2" stainless steel (size) (material)
- (6) pump 3/4 HP 6 (yield gpm)
Edeahia (type power)
- (7) electric log NO (yes or no)
- (8) how well bottom plugged 2" BW

description of formations encountered	from	to
Red Clay	1	10
Red sand + clay	10	20
CLAY	20	30
CLAY + FINE SAND	30	40
CHALK + FINE SAND	40	50
SAND + CHALK	50	57
SAND	57	63
CHALK	63	70
CHALK + SAND	80	100
SAND + CHALK	100	120
SAND	120	125
CHALK	125	138
SAND	138	140
SAND, lignite + CHALK	140	150
SAND	150	160
CHALK	160	218
Shell - SAND - CHALK	218	228
Shell - CHALK	228	238
Rock	238	248
Rock - CHALK	248	258
Shell - SAND	258	278
CHALK - SAND	278	282
SAND	282	288
CHALK + FINE SAND	288	318
CHALK - SAND - lignite	318	328
CHALK	328	335
SAND	335	348
SAND - CHALK	348	378
CHALK	378	388

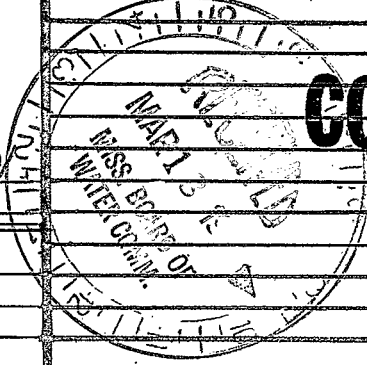


CODED

DRILLERS REMARKS:

If well telescopes please sketch and show depths.

GROUND LEVEL

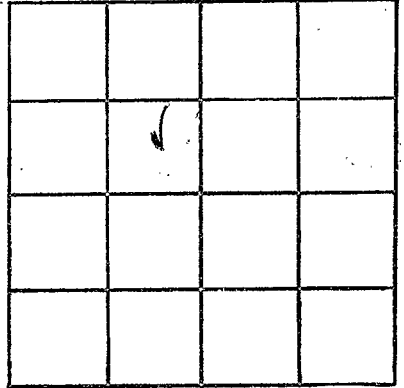

SECTION 32

Please indicate well location X.

ADDITIONAL INFORMATION

If more than one screen, show locations of each on sketch.