

RANKIN MISSISSIPPI BOARD OF WATER COMMISSIONERS

P59
6-11-61

WATER WELL DRILLERS LOG

CODED
Rankin

Date: 6-11-61, 19___, Driller: James McNeas County: Hinds
(Name)

(1) Owner of Land:	Description & Color of Materials Sand, Clay, Red Clay, Shell, etc.	Thick- ness Feet	Depth Feet
<u>Willie Berry</u> (Name)	<u>Surface soil</u>	<u>20</u>	
<u>R.F.D. 6 Jackson</u> (Address)	<u>Grey shale</u>	<u>20</u>	<u>40</u>
(2) Location: ___ 1/4, ___ 1/4, Sec. <u>8</u> T <u>4</u> R <u>2</u>	<u>Brown shale</u>	<u>44</u>	<u>84</u>
<u>3 1/2</u> miles <u>N.E.</u> of <u>Florence</u> (distance) (direction) (Nearest Town)	<u>Rock shale streaks</u>	<u>18</u>	<u>102</u>
(3) Topography: <input checked="" type="checkbox"/> (Hilly) <input type="checkbox"/> (Flat) <input type="checkbox"/> (Level)	<u>Grey shale streaks</u>	<u>37</u>	<u>139</u>
(4) Purpose of Well: <u>Domestic</u> (Domestic Irrigation, Municipal, Industrial, Other)	<u>Sand</u>	<u>3</u>	<u>142</u>
	<u>Sandy shale</u>	<u>1</u>	<u>143</u>
	<u>Sand</u>	<u>1</u>	<u>144</u>
	<u>Grey shale</u>	<u>24</u>	<u>168</u>
	<u>Sand</u>	<u>1</u>	<u>169</u>
	<u>Grey shale</u>	<u>51</u>	<u>220</u>


Information upon completion of well:

- (1) Diameter 2 inches.
- (2) Total Depth 220 feet.
- (3) Water Level 69' feet below top of ground:
- (4) Cased to 126', Size 2"
- (5) Screen: Size 2".008 Length 15'
- (6) Were any formations sealed against pollution?
_____ yes, no.

CODED

<u>6 fts. 2" Galv pipe</u>	<u>126</u>
<u>2" 008-S.S. screen</u>	<u>15</u>
	<u>141</u>
<u>1-2" collar.</u>	
<u>Back wash Valve</u>	
<u>and 2" Nipple</u>	<u>1</u>
	<u>142</u>

If YES depth of formation _____
Why _____
Drillers Remarks: _____

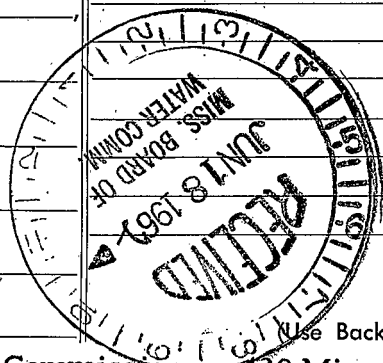

(Use Back Side)

Well No.

