

RANKIN MISSISSIPPI BOARD OF WATER COMMISSIONERS

P 62

6-21-66

WATER WELL DRILLERS LOG

CODED

Date: June 21, 1966, Driller: Burney Water Well Service, Inc. Rankin

(Name)

(1) Owner of Land: Edgar George
(Name)

Route 6, Box 172 Jackson, Miss

(Address)
Monterey Road

(2) Location: 1/4, 1/4, Sec. 8 T4R2

2 1/2 miles east, of Hwy. 49
(distance) (direction) (Nearest Town)

(3) Topography: Hilly
(Hilly) (Flat) (Level)

(4) Purpose of Well: Domestic
(Domestic Irrigation
Municipal, Industrial, Other)

Information upon completion of well:

(1) Diameter 2 inches.

(2) Total Depth 163 feet.

(3) Water Level 56 feet below top of ground.

(4) Cased to 123, Size 2"

(5) Screen: Size 2 1/2", Length 10'

(6) Were any formations sealed against pollution?

yes, no.

If YES depth of formation From surface


Why to prevent surface pollution

Drillers Remarks: Sanitary well seal

was used.

Description & Color of Materials Sand, Clay, Red Clay, Shell, etc.	Thick- ness Feet	Depth Feet
Top soil & red clay	5	5
Grey clay	17	22
Yellow & Brown clay	8	30
Black shale, & fine gravel	14	44
Layers of fine sand	4	48
Black shale	37	85
Layers of shell	4	89
Rock or limestone	25	114
Grey clay	9	123
Fine sand	5	128
Clay layers	7	135
Sand fine	5	140
Shale or clay	3	143
Shale & sand layers	20	163

CODED

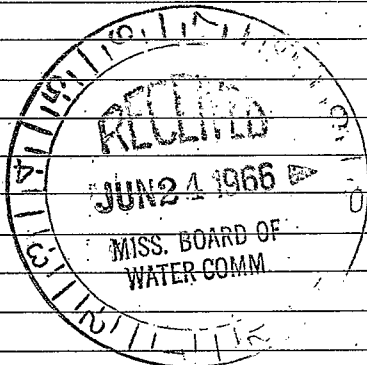

(Use Back Side)

Well No.

