

RANKIN MISSISSIPPI BOARD OF WATER COMMISSIONERS

~~11-10-62~~ P 63

11-10-62

WATER WELL DRILLERS LOG

CODED

Date: 11-10-, 1962, Driller: James McNEES County Hinds

(Name)

(1) Owner of Land: E.K. Webb
 (Name)
Florence Miss
 (Address)

(2) Location: 1/4, 1/4, Sec. 34 T4 R2
4 miles S.E. of Florence
 (distance) (direction) (Nearest Town)

(3) Topography: (Hilly) (Flat) (Level)

(4) Purpose of Well: Domestic
 (Domestic Irrigation
 Municipal, Industrial, Other)

Description & Color of Materials Sand, Clay, Red Clay, Shell, etc.	Thick- ness Feet	Depth Feet
SURFACE SOIL	5	5
ROCK. Sh STKS	15	20
Blue shale	60	80
Grey shale	28	108
SAND	15	123
Grey sdy shale	15	138
SAND	7	145
DARK Grey shale	55	200
ROCK. Sh STKS	18	218
SANDY Sh	2	220
ROCK	1	221
Grey shale	8	229
ROCK. Sh STKS	11	240
Grey shale	3	243
Grey sdy Sh	19	262
SAND	11	273
Grey shale	7	280
SAND	2	282
Grey shale	11	293

Information upon completion of well:

(1) Diameter 2 inches.

(2) Total Depth 293 feet.

(3) Water Level 103 feet below top of ground.

(4) Cased to 262', Size 2"


(5) Screen: Size 2" 007, Length 10

(6) Were any formations sealed against pollution?
 yes, no.

If YES depth of formation _____

Why _____

Drillers Remarks: _____

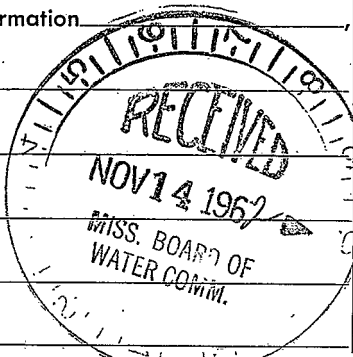

CODED

12 Jts 2"	252
1 - 2"	9
2 - 2 1/2 x 2 1/2 Swedges	1
	262
1 - 2" 007 ss screen	10
	272
1 - 2" Tail pipe	6
1 - 2" Nipple collar & B P V	1
	279

(Use Back Side)

Well No.

1944

1944