

RANKIN
P66
8-8-64

MISSISSIPPI BOARD OF WATER COMMISSIONERS

WATER WELL DRILLERS LOG

CODED

Date: 8-8-, 1964, Driller: JAMES McNEES County: _____

(Name)

(1) Owner of Land: O. D. JUBIN
(Name)
Florence MISS
(Address)

(2) Location: _____ 1/4, _____ 1/4, Sec. 19 T4R2,
_____ miles _____ of _____
(distance) (direction) (Nearest Town)

(3) Topography: (Hilly) (Flat) (Level)

(4) Purpose of Well: Domestic
(Domestic Irrigation
Municipal, Industrial, Other)

Description & Color of Materials Sand, Clay, Red Clay, Shell, etc.	Thick- ness Feet	Depth Feet
Surface Soil	10	10
SAND	10	20
Blue shale	60	80
Blue shale shells	38	118
Rock	3	121
Rock sh str	16	137
SAND	13	150
Gray sh lignite	11	161
SAND	5	166
Gray shale	17	183

Information upon completion of well:

(1) Diameter 4" inches.

(2) Total Depth 183 feet.

(3) Water Level 70 feet below top of ground.

(4) Cased to 128, Size 4


(5) Screen: Size 2,000, Length 20

(6) Were any formations sealed against pollution?
_____ yes, _____ no.

CODED

6 lbs 4	127	
1-4" x 3" Swedee	1	
2, 2" 007 ss. s	20	
	148	

If YES depth of formation _____
Why _____
Drillers Remarks: _____

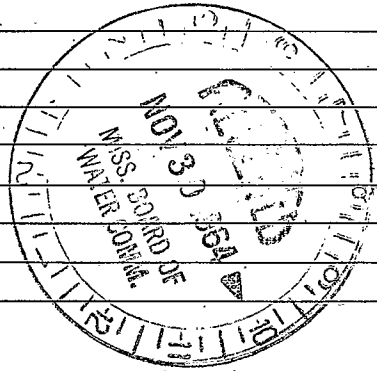

(Use Back Side)

Well No.

100

100