

Rankin
P 69
5-69

MISSISSIPPI
BOARD OF WATER COMMISSIONERS
416 North State Street
Jackson, Mississippi 39201

CODED

WATER WELL DRILLERS LOG

CODED

5-3
date well completed

1969 Layne-Central Co.
firm name

county well located

LANDOWNER:

Southern Rankin Water Assoc.

Plain, Miss.
(mailing address)

WELL LOCATION: Monterey Road

sec. 8 T 4 N R 2 E
app. 4 miles South of Plain
(distance) (direction) (nearest town)

WELL PURPOSE:
(home, irrigation, municipal, industrial)

WELL COMPLETION DATA:

- (1) diameter (inches) 8"
- (2) total depth (feet) 948'
- (3) static water level (feet) 198' below above
top of ground.
- (4) casing Steel, 889' 7 8"
(material) (depth)
8" 52' 3 6"
(size) if telescope see back.
- (5) screen 42', 905'
(length) (depth to top)
6", Stainless Steel
(size) (material)
- (6) pump _____ (HP) _____ (yield gpm)
Electric
(type power)
- (7) electric log yes
(yes or no)
Miss. Geo. Survey
(organization running log)
- (8) how well bottom plugged Blank
Bottom

description of formations encountered

	from	to
<u>Red. Clay</u>	<u>0</u>	<u>5</u>
<u>Yellow Chalk</u>	<u>5</u>	<u>25</u>
<u>Blue Clay</u>	<u>25</u>	<u>99</u>
<u>Lime</u>	<u>99</u>	<u>135</u>
<u>Clay Strcs. of Sand</u>	<u>135</u>	<u>145</u>
<u>Blue Clay</u>	<u>145</u>	<u>663</u>
<u>Clay Strcs. of Sand</u>	<u>663</u>	<u>795</u>
<u>Shale Strcs. of fine Sand</u>	<u>795</u>	<u>893</u>
<u>Shale Strcs. of Shale</u>	<u>893</u>	<u>948</u>

Commented

11/9/99

MAY 9 1969

MISS. DE. OF.
WATER COMMISSIONERS
MAY 9 1969

MISS. DE.
WATER COMMISSIONERS


DRILLERS REMARKS:

Pump not installed as of this date

(X)

If well telescopes please sketch and show depths.

GROUND LEVEL

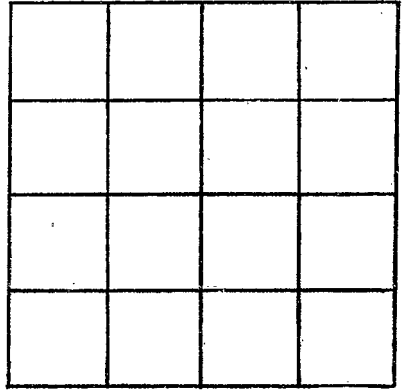

SECTION _____

Please indicate well location X.

ADDITIONAL INFORMATION

If more than one screen, show locations of each on sketch.