

Rankin
P 70
9-20-69
M. G. S.

MISSISSIPPI
BOARD OF WATER COMMISSIONERS
416 North State Street
Jackson, Mississippi 39201

CODED

WATER WELL DRILLERS LOG

Sept 20 1969 Thompson Well Dr Rankin
date well completed firm name county well located


LANDOWNER:	description of formations encountered	from	to
<u>Leson Hieber</u>			
<u>981 Bot 338 Johnson</u> (mailing address)			
WELL LOCATION: sec. <u>36</u> T. <u>4</u> N. R. <u>2</u> E <u>3</u> miles <u>9</u> of <u>Star</u> (distance) (direction) (nearest town)			
WELL PURPOSE: <u>Home</u> (home, irrigation, municipal, industrial)			
WELL COMPLETION DATA: (1) diameter (inches) <u>2"</u> (2) total depth (feet) <u>223'</u> (3) static water level (feet) <u>80'</u> below above top of ground. (4) casing <u>Plastic 98'</u> (material) (depth) <u>2"</u> (size) if telescope see back. (5) screen <u>5'</u> , <u>98'</u> (length) (depth to top) <u>2"</u> , <u>Plastic</u> (size) (material) (6) pump <u>3/4</u> <u>6</u> (HP) (yield gpm) <u>Gas</u> (type power) (7) electric log <u>yes</u> (yes or no) <u>M. G. S.</u> (organization running log) (8) how well bottom plugged <u>B/w water</u>			
DRILLERS REMARKS:			

CODED

OCT 21 1969
MISS. DE. OF
WATER CONTROL

If well telescopes please sketch and show depths.

GROUND LEVEL

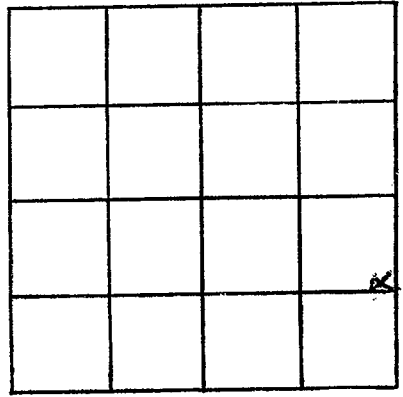

SECTION 36

Please indicate well location X.

ADDITIONAL INFORMATION

If more than one screen, show locations of each on sketch.