

RANKIN
~~59~~ P76
12-10-72 71

MISSISSIPPI
BOARD OF WATER COMMISSIONERS
416 North State Street
Jackson, Mississippi 39201

WATER WELL DRILLERS LOG

CODED

12/10 1972 date well completed
Jack C. Linn Rankin firm name
county well located

LANDOWNER:
Estus Berry
Florence, Miss.
(mailing address)

description of formations encountered	from	to
Lag soil	0	28
yellow sand	28	60
Blue clay	60	140
Sand	140	220
Shell	220	272

WELL LOCATION:
sec. 33 4(N) R. 2(E)
2 1/2 miles N of Florence
(distance) (direction) (nearest town)

WELL PURPOSE: Domestic
(home, irrigation, municipal, industrial)

- WELL COMPLETION DATA:
- (1) diameter (inches) 4 in
 - (2) total depth (feet) 272
 - (3) static water level (feet) 40 below above top of ground.
 - (4) casing black (material) (depth)
4 in (size) if telescope see back.
 - (5) screen 15 (length) 168 (depth to top)
2 in (size) SS (material)
 - (6) pump 1 (HP) 10 gal (yield gpm)
P.E.A. (type power)
 - (7) electric log yes (yes or no)
W.S. S.S. (organization running log)

CODED


(8) how well bottom plugged
Back wash valve

DRILLERS REMARKS:

MADE * 4 10/72
WAT 11 10/72

If well telescopes please sketch and show depths.

GROUND LEVEL

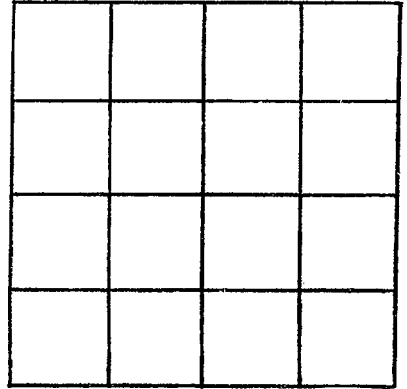

SECTION _____

Please indicate well location X.

ADDITIONAL INFORMATION

If more than one screen,
show locations of each on sketch.