

E353

RANKIN

P82 77

12-16-71

MISSISSIPPI BOARD OF WATER COMMISSIONERS  
416 North State Street  
Jackson, Mississippi 39201

CODED

WATER WELL DRILLERS LOG

12/16

date well completed

71 Jack C. Linn

firm name

Rankin

county well located

LANDOWNER

E. Barnett  
Florence

description of formations encountered

from

to

Top soil	0	20
yellow sand	30	80
Blue clay	80	160
sand	160	228
sands shell	228	300

(mailing address)

WELL LOCATION:

sec 23 T 40 N R 2 E  
2 miles NW of Florence  
(distance) (direction) (nearest town)

WELL PURPOSE: Home  
(home, irrigation, municipal, industrial)

WELL COMPLETION DATA:

- (1) diameter (inches) 4 in.
- (2) total depth (feet) 300
- (3) static water level (feet) 75 below top of ground.
- (4) casing Black 200 ft. (material) (depth)
- 4 in. (size) if telescope see back.
- (5) screen 15 ft. 200 ft. (length) (depth to top)
- 2 in. (size) SS (material)
- (6) pump 1 (HP) 10 gal. (yield gpm)
- P.E.a (type power)
- (7) electric log Yes (yes or no)
- M.S.S. (organization running log)

CODED

(8) how well bottom plugged  
Back wash valve


MAY 11 1972

DRILLERS REMARKS:

MISS. BU. OF WATER COMMISSIONERS

If well telescopes please sketch and show depths.

GROUND LEVEL

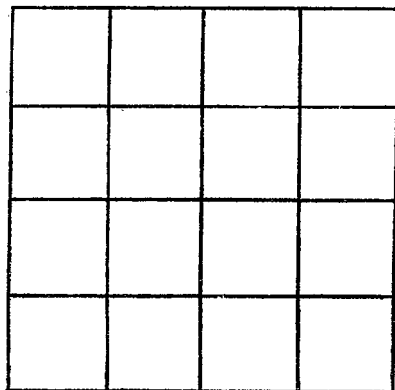

SECTION \_\_\_\_\_

Please indicate well location X.

ADDITIONAL INFORMATION

If more than one screen,  
show locations of each on sketch.