

FLOG # 354

MISSISSIPPI  
BOARD OF WATER COMMISSIONERS  
416 North State Street  
Jackson, Mississippi 39201

**CODED**

WATER WELL DRILLERS LOG

**RANKIN**  
**P8478**  
**1-30-72**

1/30 1972 Jack Lewis Rankin  
date well completed firm name county well located

LANDOWNER: E. Barnett  
Flomence, Miss.  
(mailing address)

description of formations encountered

from to

top soil	0	20
Chopped clay	20	40
yellow sand	40	100
Blue grey sand & shells	100	172
		274

WELL LOCATION:  
33 sec. 44 T. 40 N. R. 2 E. W  
2 miles NW of Flomence  
(distance) (direction) (nearest town)

WELL PURPOSE: Domestic  
(home, irrigation, municipal, industrial)

- WELL COMPLETION DATA:
- (1) diameter (inches) 2 in.
  - (2) total depth (feet) 274
  - (3) static water level (feet) 90 below top of ground. above
  - (4) casing Galv. 172  
(material) (depth)  
2 in. if telescope see back.  
(size)
  - (5) screen 10 ft. 172  
(length) (depth to top)  
2 in. 55  
(size) (material)
  - (6) pump 14.0 4 gal.  
(HP) (yield gpm)  
P.E.A.  
(type power)
  - (7) electric log yes  
(yes or no)  
R.S.P.  
(organization running log)
  - (8) how well bottom plugged back  
was value

**CODED**


MAY 11 1972

DRILLERS REMARKS:

WELL DRILLER'S NAME  
ADDRESS  
CITY

If well telescopes please sketch and show depths.

GROUND LEVEL

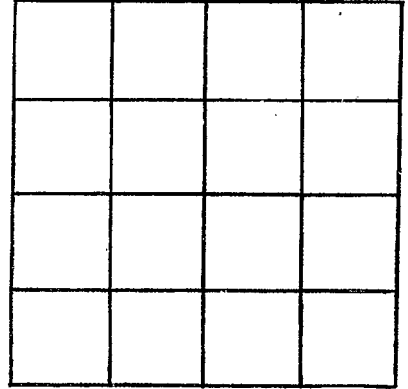

SECTION \_\_\_\_\_

Please indicate well location X.

ADDITIONAL INFORMATION

If more than one screen,  
show locations of each on sketch.