

RANKIN
P80
1-8-72

MISSISSIPPI
BOARD OF WATER COMMISSIONERS
416 North State Street
Jackson, Mississippi 39201

WATER WELL DRILLERS LOG

CODED

Jan 8 1972 K. E. Thompson Rankin
date well completed firm name county well located

LANDOWNER:	description of formations encountered	from	to
E. C. Wimer	top soil	0	5
Bramble grass. (mailing address)	Red clay	5	25
WELL LOCATION: sec. 36 T 4 N R 2 E 3 miles N of Star (distance) (direction) (nearest town)	Blue clay	25	45
WELL PURPOSE: home (home, irrigation, municipal, industrial)	Dark Blue clay	45	59
WELL COMPLETION DATA: (1) diameter (inches) 2" (2) total depth (feet) 160' (3) static water level (feet) 90 below above top of ground. (4) casing Plastic, 150' (material) (depth) 2" if telescope see back. (size) (5) screen 10' x 2", 150' (length) (depth to top) .006, Plastic (size) (material) (6) pump 1 (HP) 4 (yield gpm) Jet (type power) (7) electric log no (yes or no) (organization running log) (8) how well bottom plugged B/W valve	Blue clay	59	145
DRILLERS REMARKS:	sand	145	160


CODED

JAN 25 1972

MISS. DEPT. OF
WATER RESOURCES

If well telescopes please sketch and show depths.

GROUND LEVEL

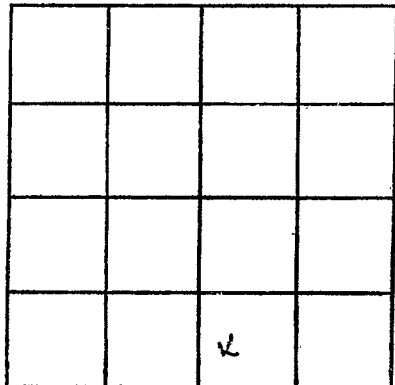

SECTION 36

Please indicate well location X.

ADDITIONAL INFORMATION

A series of horizontal lines for recording additional information.

If more than one screen, show locations of each on sketch.