

RANKIN
P82
Elm #359

MISSISSIPPI
 BOARD OF WATER COMMISSIONERS
 416 North State Street
 Jackson, Mississippi 39201

Coded

WATER WELL DRILLERS LOG

June 13 1972 date well completed J. E. Thompson firm name RANKIN county well located


LANDOWNER:	description of formations encountered	from	to
<u>Miss. Power Co.</u>	<u>topsoil</u>	<u>0</u>	<u>5</u>
<u>B. B. Gordon, Jr.</u> (mailing address)	<u>sandy</u>	<u>5</u>	<u>30</u>
WELL LOCATION:	<u>clay</u>	<u>30</u>	<u>50</u>
sec. <u>27</u> T. <u>4</u> N. R. <u>2</u> E.	<u>sandy</u>	<u>50</u>	<u>75</u>
. <u>3</u> miles <u>E</u> of <u>Florence</u> (distance) (direction) (nearest town)	<u>blue clay</u>	<u>75</u>	<u>140</u>
WELL PURPOSE: <u>Home</u> (home, irrigation, municipal, industrial)	<u>fine sand</u>	<u>140</u>	<u>169</u>
WELL COMPLETION DATA:			
(1) diameter (inches) <u>2"</u>			
(2) total depth (feet) <u>169'</u>			
(3) static water level (feet) <u>50'</u> <u>(below)</u> above top of ground.			
(4) casing <u>Plastic 83'</u> (material) (depth) <u>2"</u> (size) if telescope see back.			
(5) screen <u>5'</u> <u>83'</u> (length) (depth to top) <u>.008</u> <u>Plastic</u> (size) (material)			
(6) pump <u>1/2</u> <u>4</u> (HP) (yield gpm)			
<u>Gas</u> (type power)			
(7) electric log <u>Yes</u> (yes or no)			
<u>M. S. S.</u> (organization running log)			
(8) how well bottom plugged <u>OK</u>			
DRILLERS REMARKS:			

AUG 20 1972

MISS. BD. OF
 WATER COM. 1

If well telescopes please sketch and show depths.

GROUND LEVEL

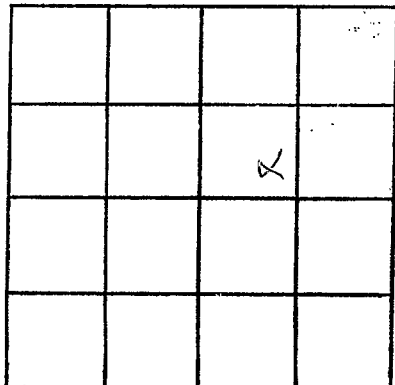

SECTION 27

Please indicate well location X.

ADDITIONAL INFORMATION

Lined area for additional information.

If more than one screen, show locations of each on sketch.