

RANKIN
P 83
6-14-72

MISSISSIPPI
 BOARD OF WATER COMMISSIONERS
 416 North State Street
 Jackson, Mississippi 39201

CODED

WATER WELL DRILLERS LOG

June 14 1972 R. E. Thomas Rankin
 date well completed firm name county well located


LANDOWNER:	description of formations encountered	from	to
<u>M. E. Mc Lin</u>			
(mailing address)			
WELL LOCATION: sec. <u>34</u> T. <u>4</u> N. R. <u>2</u> E. <u>S</u> <u>W</u> <u>3</u> miles <u>E</u> of <u>Falcons</u> (distance) (direction) (nearest town)			
WELL PURPOSE: (home, irrigation, municipal, industrial)			
WELL COMPLETION DATA: (1) diameter (inches) <u>2</u> (2) total depth (feet) <u>128'</u> (3) static water level (feet) <u>30'</u> below above top of ground. (4) casing <u>PVC</u> <u>128'</u> (material) (depth) <u>2"</u> If telescope see back. (size) (5) screen <u>15" x 2"</u> <u>128'</u> (length) (depth to top) <u>306</u> <u>PVC</u> (size) (material) (6) pump <u>1</u> <u>6</u> (HP) (yield gpm) <u>Jet</u> (type power) (7) electric log <u>no</u> (yes or no) _____ (organization running log) (8) how well bottom plugged <u>plugged</u>			
DRILLERS REMARKS:			

CODED

JUL 12 1972

If well telescopes please sketch and show depths.

GROUND LEVEL

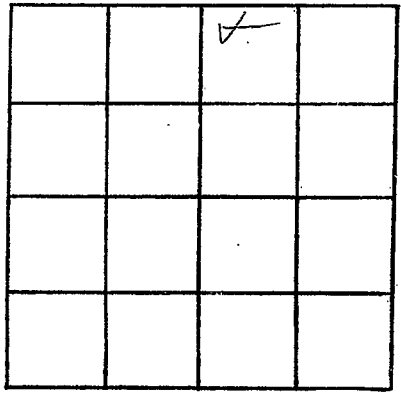

SECTION 34

Please indicate well location X.

ADDITIONAL INFORMATION

A series of horizontal lines for writing additional information, located below the 'ADDITIONAL INFORMATION' header.

If more than one screen, show locations of each on sketch.