

RANKIN

MISSISSIPPI BOARD OF WATER COMMISSIONERS

P86

7-7-66

WATER WELL DRILLERS LOG

CODED

Date: 7/7, 1966, Driller: Forest Dilling County Rankin (Name)

(1) Owner of Land: Joe Allister (Name) Brandon, Miss (Address)

(2) Location: 1/4, 1/4, Sec. 17 T4R2, Henton Rd. miles of Brandon (distance) (direction) (Nearest Town)

(3) Topography: (Hilly) (Flat) (Level)

(4) Purpose of Well: Home (Domestic Irrigation Municipal, Industrial, Other)


Description & Color of Materials Sand, Clay, Red Clay, Shell, etc.	Thick- ness Feet	Depth Feet
yellow Clay + sand		28
Red Clay		30
Blue Clay		174
Rock		179
Rock + Sh. Clay		184
Rock line, + shell		205
Sft Clay, lime + shell		225
Shale		683
Thin shell + shale		697
Shale		861
Fine sand + soft shale		890
Shale		903
Fine sand		909
Shale		921
Fine sand		924
F. sand + soft shale		956
Fine sand		966

Information upon completion of well:

- (1) Diameter 2 inches.
- (2) Total Depth 963 feet.
- (3) Water Level 200 feet below top of ground.
- (4) Cased to 945, Size 2"
- (5) Screen: Size 2", Length 18
- (6) Were any formations sealed against pollution?  
yes, no.

If YES depth of formation: Why: Drillers Remarks:

CODED

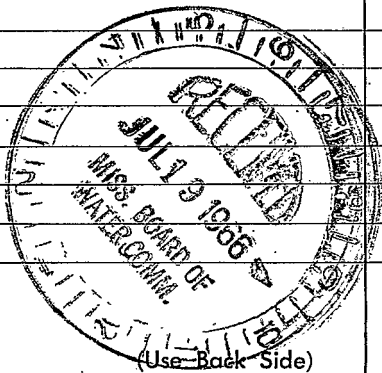

Well No.

100

100

