

RANKIN
P 87
7-17-73

MISSISSIPPI
 BOARD OF WATER COMMISSIONERS
 416 North State Street
 Jackson, Mississippi 39201

CODED

WATER WELL DRILLERS LOG

7/17 date well completed 1973 Forest Drilling firm name Rankin county well located

LANDOWNER: Willie Lee Hicks
Rt 4 - Florence Miss
 (mailing address)

WELL LOCATION:
 sec 7 T 4 N R 2 E
3 miles N of Florence
 (distance) (direction) (nearest town)

WELL PURPOSE:
 (home, irrigation, municipal, industrial)

WELL COMPLETION DATA:

(1) diameter (inches) 2
 (2) total depth (feet) 1306
 (3) static water level (feet) 245 below top of ground. 1291' above
 (4) casing Galv. (material) 1306 (depth)
 (size) #3 if telescope see back.
 (5) screen 15x2" (length) 1291' (depth to top)
2 (size) Stainless S. (material)
 (6) pump 5 HP (HP) 19 (yield gpm)
Electric - 230V (type power)
 (7) electric log no (yes or no)
no (organization running log)
 (8) how well bottom plugged 2" B.W.
valve


description of formations encountered	from	to
Brown Clay	0	36
Blue Clay	36	81
Clay + Shell	81	91
Clay + rock	91	132
Clay + St Sand	132	172
Clay	172	183
Clay + St Sand	183	195
Clay	195	265
Shale	265	574
Shale + St rock	574	624
Clay + St	624	634
Clay + Shale	634	906
Clay + St Sand	906	948
Shale	948	1011
Shale + rock	1011	1095
Shale	1095	1116
Shale + St Sand	1116	1240
Thin Sand + St Clay	1240	1282
Sand	1282	1306

DRILLERS REMARKS:

SEP 20 1973

If well telescopes please sketch and show depths.

GROUND LEVEL

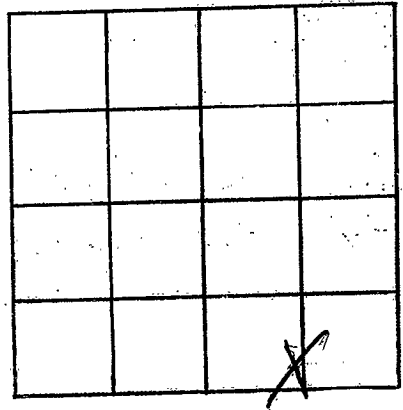

SECTION 7

Please indicate well location X.

ADDITIONAL INFORMATION

If more than one screen,
show locations of each on sketch.