

RANKIN
P 89
4- 76
Elas 421

MISSISSIPPI
 BOARD OF WATER COMMISSIONERS
 416 North State Street
 Jackson, Mississippi 39201

CODED

WATER WELL DRILLERS LOG

date well completed mid 1976 firm name GRINER DRILLING SERVICE county well located RANKIN

LANDOWNER: SOUTHERN RANKIN WATER ASSN.
Well #3
 (mailing address)

description of formations encountered	from	to
Top Soil	0	3
CLAY	3	70
LIME Rock/strata of SAND	70	190
CLAY (PAZCO)	190	638
SANDY CLAY + SAND strata	638	710
CLAY	710	830
SAND w/ clay strata	830	902
CLAY + LIMESTONE, hard	902	1119
SAND + CLAY strata	1119	1228
SANDY CLAY	1228	1250
SAND, fine	1250	1338
CLAY, hard	1338	1375

WELL LOCATION: W/center of Sulpis
 sec. 18 T. 4 N. R. 2 E. S. 1 W.
 (distance) miles _____ of _____ (direction) _____ (nearest town)

WELL PURPOSE: (home, irrigation, municipal, industrial)


- WELL COMPLETION DATA:
- (1) diameter (inches) 10 3/4
 - (2) total depth (feet) 1295
 - (3) static water level (feet) 205 ^{below} _{above} top of ground.
 - (4) casing B.I., 1243,
 (material) (depth)
10 3/4 if telescope see back.
 (size) 1.014
 - (5) screen 40, 1254
 (length) (depth to top)
6, 304 S.S. (0.1A)
 (size) GRANITE PACK (material)
 - (6) pump 20, 150
 (HP) (yield gpm)
Elect.
 (type power)
 - (7) electric log Yes
 (yes or no)
MGS
 (organization running log)

CODED

Sp. Capacity = 2.317 24

(8) how well bottom plugged BACK
WASH WASTE

DRILLERS REMARKS:

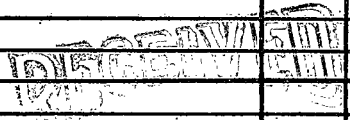

APR - 8 1976

①

If well telescopes please sketch and show depths.

GROUND LEVEL

SECTION _____

Please indicate well location X.

ADDITIONAL INFORMATION

If more than one screen, show locations of each on sketch.