

RANKIN
P92
10/16/77
Elog #441

MISSISSIPPI
 BOARD OF WATER COMMISSIONERS
 416 North State Street
 Jackson, Mississippi 39201

WATER WELL DRILLERS LOG

10/16 1977 Jack C. Quinn Rankin
 date well completed firm name county well located

LANDOWNER: Slater R. Anderson

description of formations encountered

from to

Red sand	0	60
Blue Clay	60	120
Sandy Shell	120	140
Wicksburg Sand	140	160
	160	182

(mailing address)

WELL LOCATION:

sec 30 T 4 N R 2 E
 S W
 miles Young Abbe
 (distance) (direction) (nearest town)

WELL PURPOSE:

(home) irrigation, municipal, industrial

WELL COMPLETION DATA:

- (1) diameter (inches) 6 1/2
- (2) total depth (feet) 187 ft.
- (3) static water level (feet) 100 below/above top of ground.
- (4) casing P.V.C. 40 164 ft.
 (material) (depth)
4 in. if telescope see back.
 (size)
- (5) screen 20 ft. 164 ft.
 (length) (depth to top)
4 in. P.V.C. - 40
 (size) (material)
- (6) pump 1 7 gal.
 (HP) (yield gpm)
m. P. I.
 (type power)
- (7) electric log yes
 (yes or no)
m. P. I.
 (organization running log)
- (8) how well bottom plugged back wash valve


DRILLERS REMARKS:

RECEIVED
 APR 19 1978

MISS. BD. OF WATER COMM

If well telescopes please sketch and show depths.

GROUND LEVEL

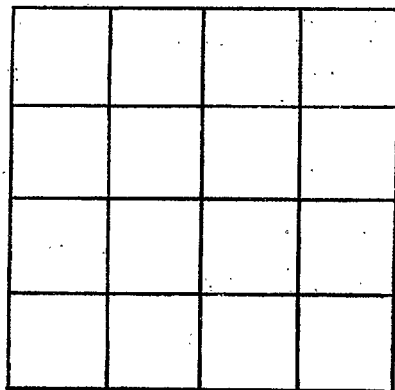

SECTION _____

Please indicate well location X.

ADDITIONAL INFORMATION

If more than one screen,
show locations of each on sketch.