

RANKIN  
P93  
11/24/78  
Elog #476

MISSISSIPPI  
BOARD OF WATER COMMISSIONERS  
416 North State Street  
Jackson, Mississippi 39201

CODED

WATER WELL DRILLERS LOG

11/24/78 Griner Drilling Rankin  
date well completed firm name county well located

LANDOWNER:	description of formations encountered	from	to
HUNT Energy Co. <del>4615 SW Freeway Ste</del> 1015 East Houston, Texas 77027 (mailing address)	Top soil	0	3
	SAND	3	20
	SAND + CLAY STREAKS	20	140
	CLAY	140	200
WELL LOCATION: Sec. 35 T. 4 S. R. 20 W. NE 1/4	SAND LIME ROCK STREAKS	200	264
(distance) miles _____ of _____ (nearest town)	SAND + CLAY STREAKS	264	338
WELL PURPOSE: oil field supply (home, irrigation, municipal, industrial)	CLAY	338	762
WELL COMPLETION DATA:	SAND w/ shells	762	782
(1) diameter (inches) 3"	SAND STREAKS OF CLAY	782	890
(2) total depth (feet) 1407'	CLAY + ROCKS	890	1064
(3) static water level (feet) 110' <sup>below</sup> above top of ground.	SAND STREAKS w/ CLAY	1064	1108
(4) casing steel 1378" (material) (depth)	CLAY + LIME ROCK (HARD)	1108	1268
3" (size) if telescope see back.	CLAY + SAND STREAKS	1268	1310
(5) screen 42' 1336' (length) (depth to top)	SAND	1310	1366
3" perforated (size) (material)	CLAY	1366	1407
(6) pump - 65-70 (HP) (yield gpm)			
AC (type power)			
(7) electric log yes (yes or no)			
Ms. Geological Survey (organization running log)			
(8) how well bottom plugged orange peel			
DRILLERS REMARKS:			

CODED


RECEIVED

DEC - 5 1978

MISS. BD. OF WATER COMMISSIONERS

If well telescopes please sketch and show depths.

GROUND LEVEL

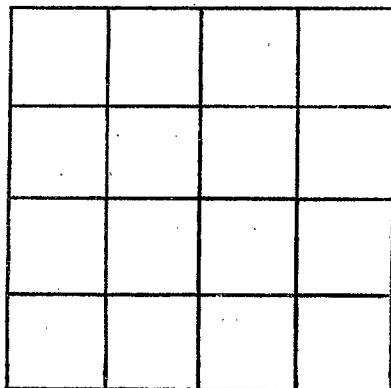

SECTION \_\_\_\_\_

Please indicate well location X.

ADDITIONAL INFORMATION

If more than one screen, show locations of each on sketch.