

RANKIN
 P 95
 3/27/79
 E Log # 487

MISSISSIPPI
 BOARD OF WATER COMMISSIONERS
 416 North State Street
 Jackson, Mississippi 39201

CODED

WATER WELL DRILLERS LOG

3-27-1979 Gunn water well Rankin
 date well completed firm name county well located

LANDOWNER:
 Danny Morse
 (mailing address)

description of formations encountered	from	to
CLAY	0	50
Rock & shale	50	90
SHALE	90	100

WELL LOCATION:
 sec. 3 T. 4 N. R. 2 E
 (distance) miles (direction) of (nearest town)

WELL PURPOSE:
 (home, irrigation, municipal, industrial)

CODED

WELL COMPLETION DATA:
 (1) diameter (inches) 4
 (2) total depth (feet) 100
 (3) static water level (feet) 36 below above-top of ground.
 (4) casing PVC 90 (material) (depth)
 4 (size) if telescope see back.
 (5) screen 20 90 (length) (depth to top)
 4 PVC (size) (material)
 (6) pump 1 15 (HP) (yield gpm)
 (type power)
 (7) electric log (yes or no)
 MAS (organization running log)
 (8) how well bottom plugged B W

Miss. Board of Water Comm.


APR 25 1979

RECEIVED

DRILLERS REMARKS:

If well telescopes please sketch and show depths.

GROUND LEVEL

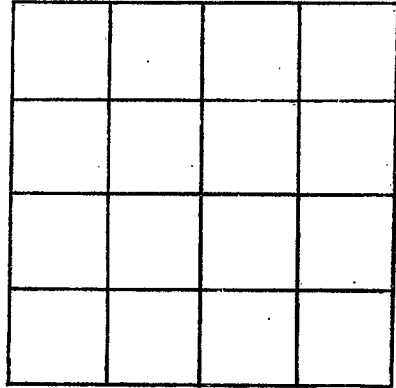

SECTION _____

Please indicate well location X.

ADDITIONAL INFORMATION

If more than one screen, show locations of each on sketch.