

RANKIN
P98
10-31-80
Elog # 510

MISSISSIPPI
BOARD OF WATER COMMISSIONERS
416 North State Street
Jackson, Mississippi 39201

CODED

WATER WELL DRILLERS LOG

10-31-80 1980 Lebanon Drilling Co. Rankin
date well completed, firm name county well located
Test not drilled (well not completed)

LANDOWNER:
Mr. Sam Dixon
Vaughan, MS.
(mailing address)

WELL LOCATION:
sec. 6 T 4 N R 2 E
2 miles S. East of Richland
(distance) (direction) (nearest town)


WELL PURPOSE: municipal
(home, irrigation, municipal, industrial)

WELL COMPLETION DATA:

(1) diameter (inches) 6"
(2) total depth (feet) 1153
(3) static water level (feet) 205 below above top of ground.
(4) casing stl 1025
(material) (depth)
(size) if telescope see back.
(5) screen 80 1075
(length) (depth to top)
4" Stainless Stl
(size) (material)
(6) pump none
(HP) (yield gpm)
(type power)
(7) electric log yes
(yes or no)
B.O.M.
(organization running log)
(8) how well bottom plugged
backwash

description of formations encountered	from	to
<u>Clear Sand</u>	<u>0</u>	<u>20</u>
<u>Sand</u>	<u>20</u>	<u>75</u>
<u>Shale</u>	<u>75</u>	<u>120</u>
<u>Sand</u>	<u>120</u>	<u>590</u>
<u>Shale</u>	<u>590</u>	<u>650</u>
<u>Sand</u>	<u>650</u>	<u>710</u>
<u>Shale</u>	<u>710</u>	<u>1030</u>
<u>Sand</u>	<u>1030</u>	<u>1160</u>

5
1050
1100

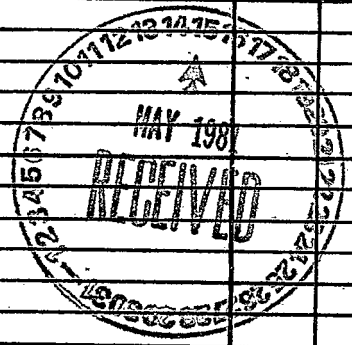


DRILLERS REMARKS:
Well does have a pump
at this time.

(A)

If well telescopes please sketch and show depths.

GROUND LEVEL

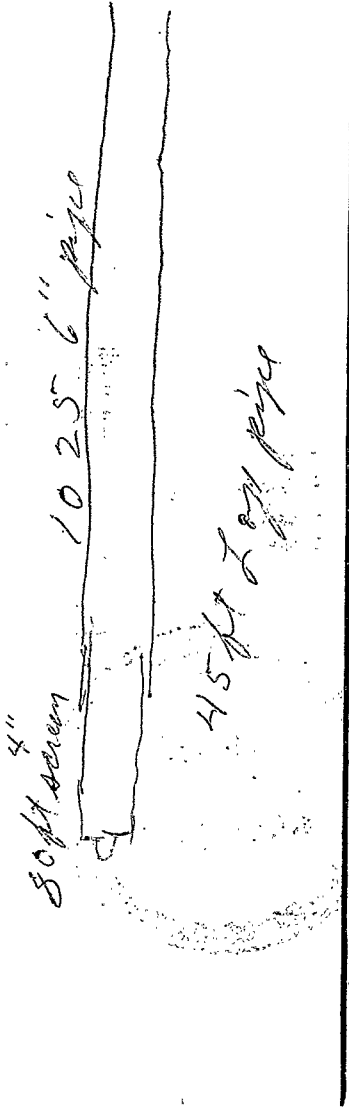

If more than one screen, show locations of each on sketch.

SECTION _____

Please indicate well location X.

ADDITIONAL INFORMATION

1025
75
950